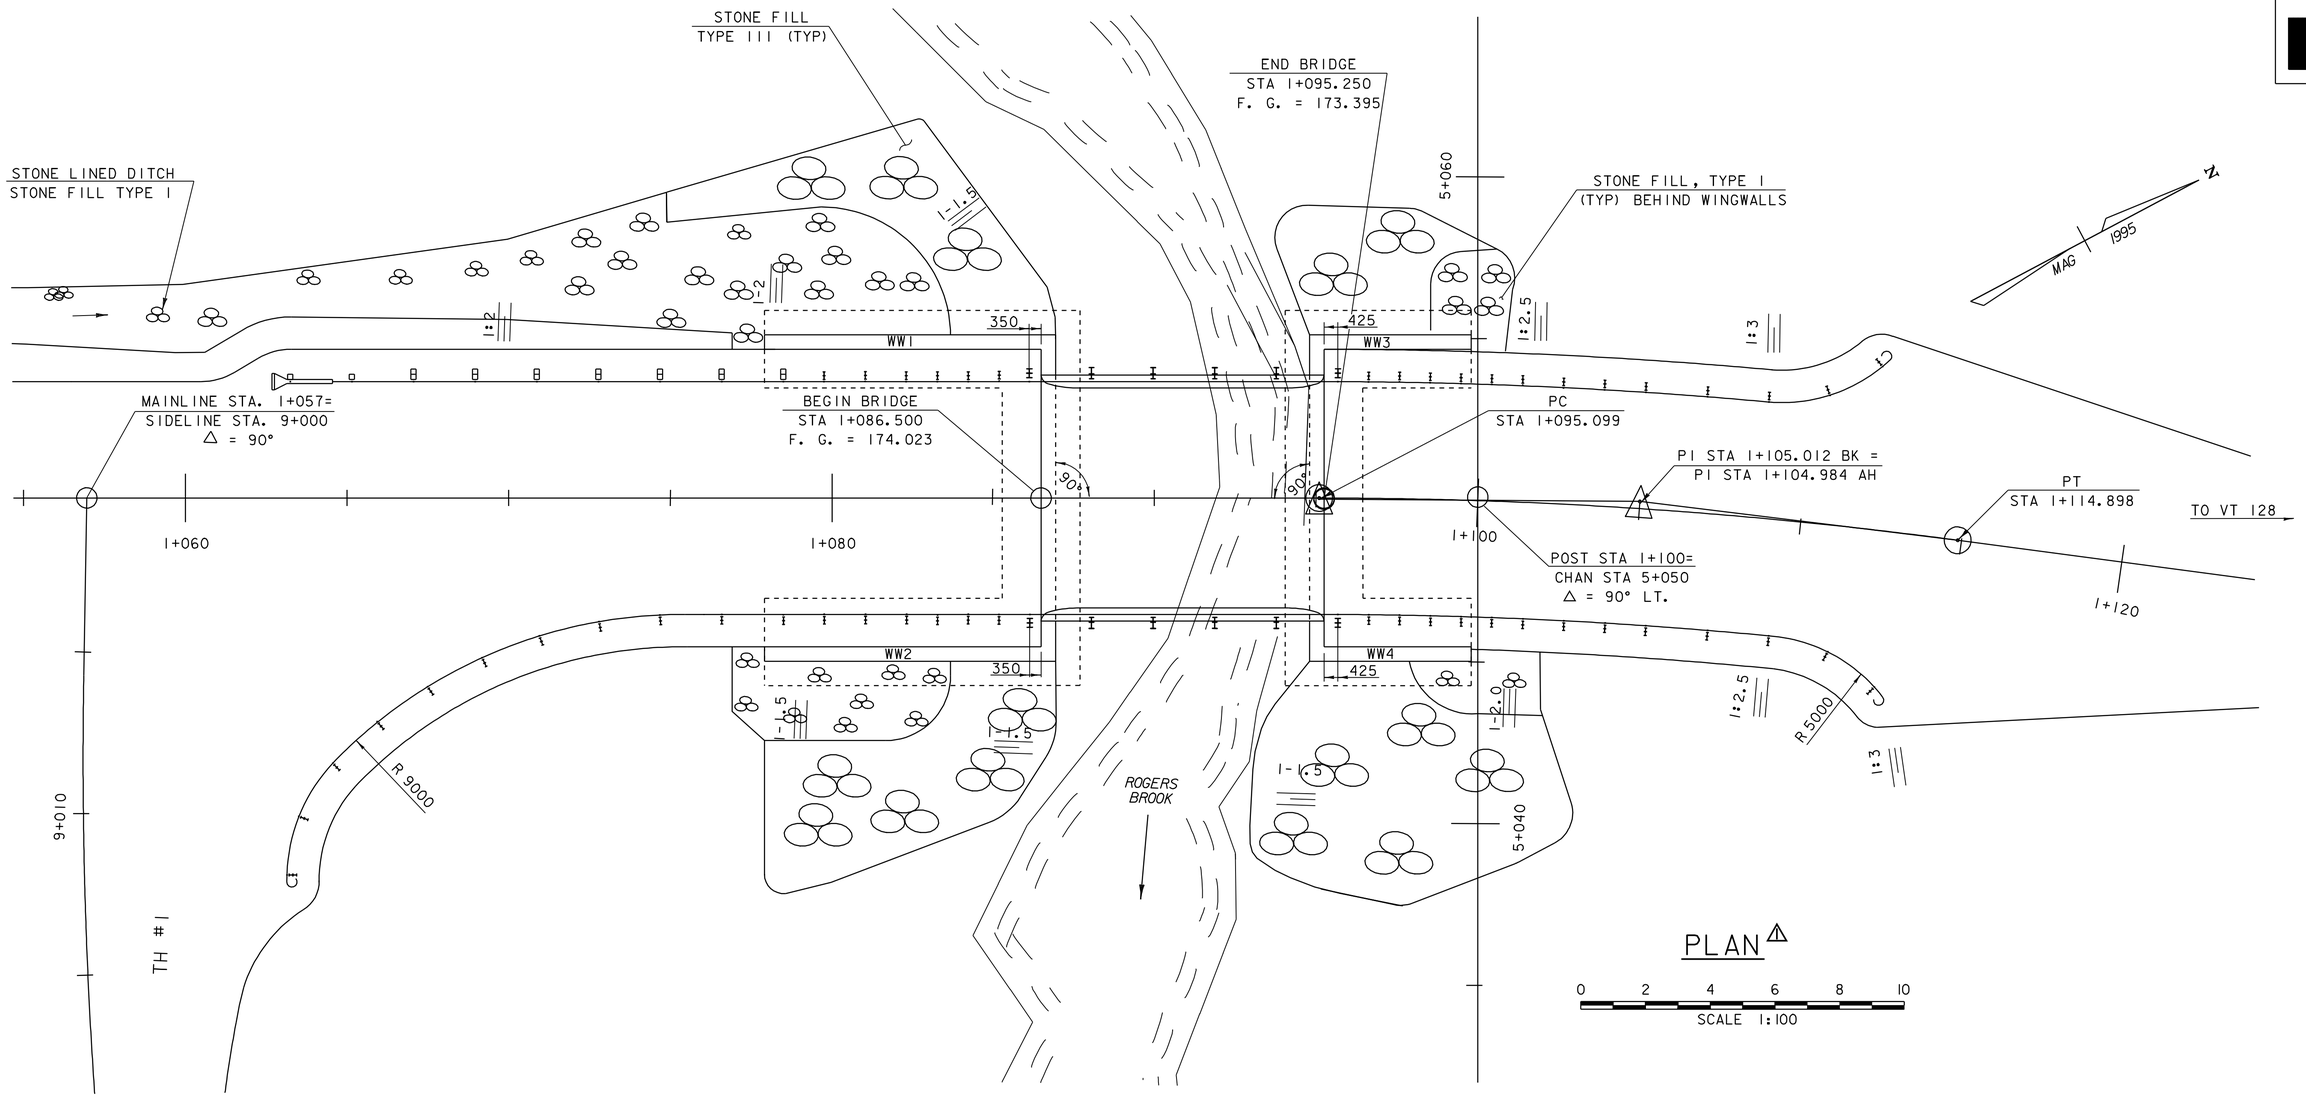

PLAN ⚠

0 2 4 6 8 10

SCALE 1:100

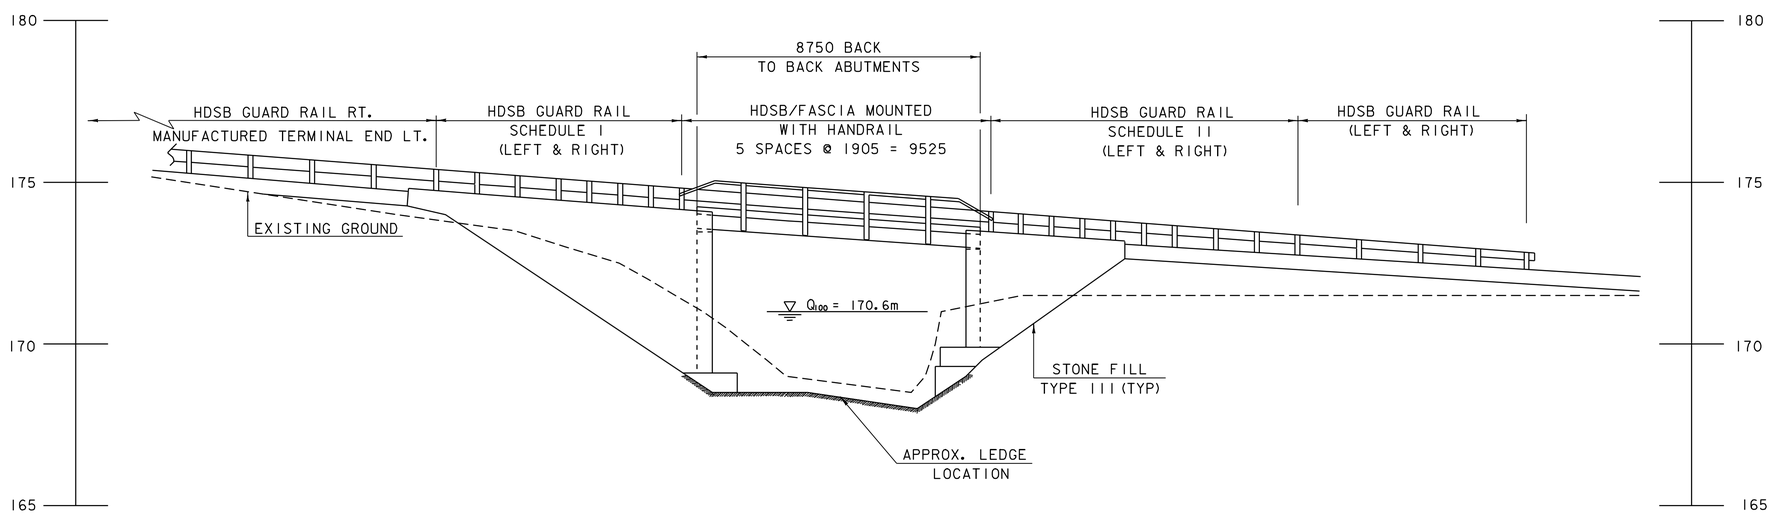

ELEVATION ⚠

0 2 4 6 8 10

SCALE 1:100

REVISION	DATE	BY	CHK'D	DESCRIPTION
⚠	06/27/2005	GFR	CWC	ABUTMENTS MODIFIED DUE TO UPDATED LEDGE INFORMATION.

SHEET NAME: **PLAN AND ELEVATION**

PROJECT NAME: WESTFORD
PROJECT NUMBER: TH2 9436

HIGHWAY NO.: TH 4
BRIDGE NO.: 2
OVER: ROGERS BROOK

FILE NAME: 94J22\Structures\sJ22pe.dgn
PROJECT MANAGER: R. R. WHITCOMB
DESIGNED BY: C. CARLSON
BRIDGE SHEET NUMBER:

PLOT DATE: 22-DEC-2006
DRAWN BY: J.GILMORE
IPARM NAME: sJ22pe.I
SHEET 19 OF 56