BRIDGE RAILING - HDSB
/FASCIA MOUNTED/
HANDRAIL (MOD.)

STA. 1+084.600 RT. - STA. 1+113.380 RT.
STA. 1+083.500 LT. - STA. 1+113.380 LT.

HDSB GUARD RAIL WITH WOOD POSTS (WEATHERING)

STA. 1+047.500 RT. - STA. 1+084.600 RT.
STA. 1+113.380 RT. - STA. 1+128.640 RT.
STA. 1+082.370 LT. - STA. 1+083.500 LT.
STA. 1+113.380 LT. - STA. 1+127.700 LT.

STONE FILL, TYPE I (IN DITCHES)

STA. 1+025.000 LT. - STA. 1+080.500 LT.
STA. 1+112.500 RT. - STA. 1+145.000 RT.

CONSTRUCT DRIVE

STA. 1+078.000 LT.
STA. 1+142.000 LT.

ANCHOR FOR STEEL BEAM RAIL

STA. 1+048.500 RT.
STA. 1+082.443 LT.
STA. 1+127.500 RT.
STA. 1+125.600 LT.

PIPE OPTION (450)

STA. 1+040
CSP
CPEP
CAAP

STA. 1+113.900 - 1+147.500 LT.
CSP
CPEP
CAAP

GABION WALL

STA. 1+044.800 RT. - STA. 1+080.800 RT.

RELOCATION OF MAILBOX

STA. 1+134.400 LT.

DECIDUOUS TREES
(SEE GENERAL NOTE #19)

STA. 1+109.500 LT. +/- - STA. 1+120.000 LT. +/-

EXISTING R.O.W. IS 3 RODS (49.5')
AS CLAIMED BY
THE TOWN OF MONTGOMERY
SELECT BOARD

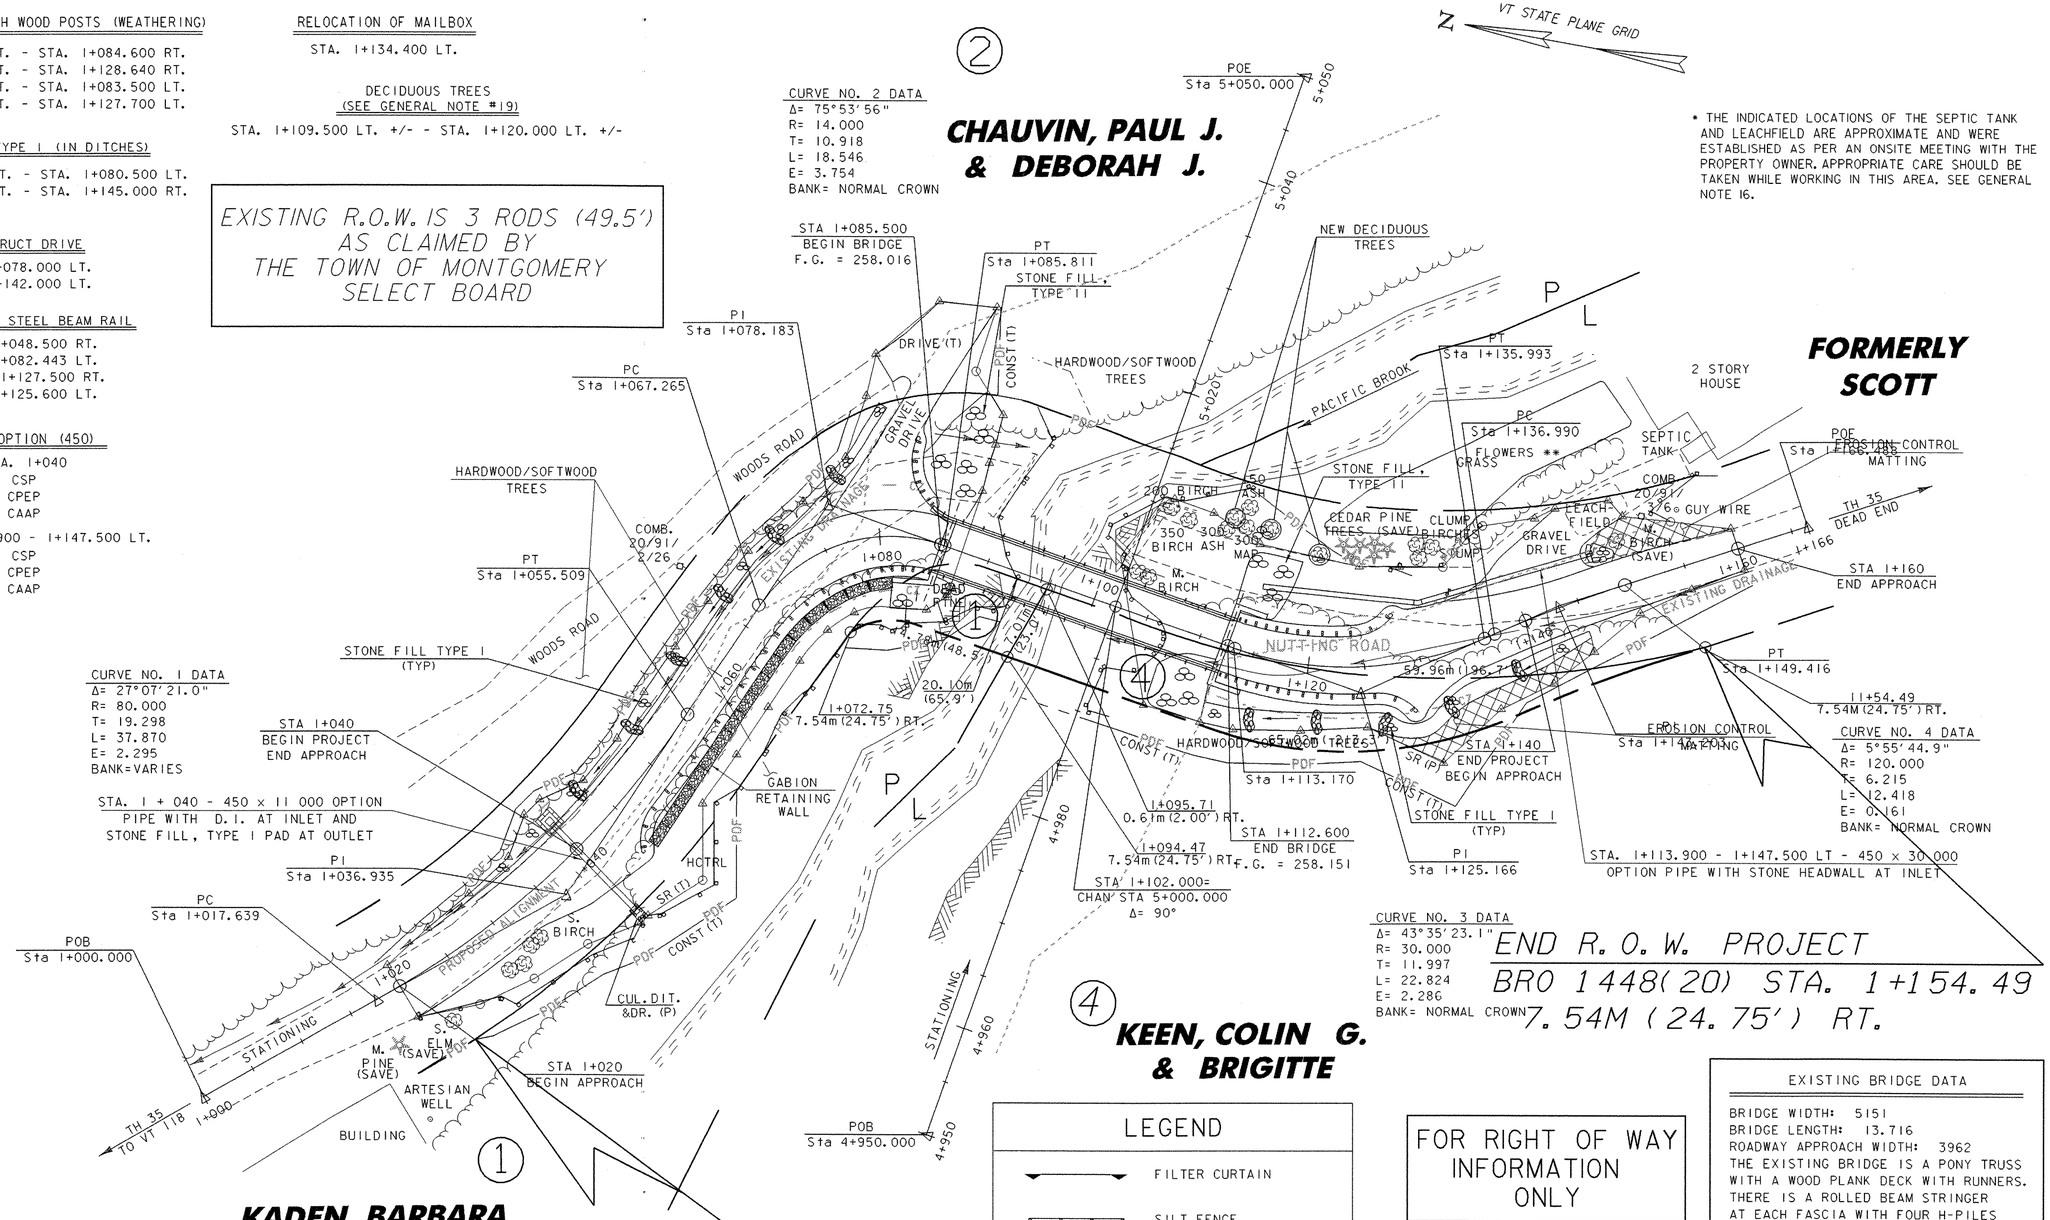

• THE INDICATED LOCATIONS OF THE SEPTIC TANK AND LEACHFIELD ARE APPROXIMATE AND WERE ESTABLISHED AS PER AN ONSITE MEETING WITH THE PROPERTY OWNER. APPROPRIATE CARE SHOULD BE TAKEN WHILE WORKING IN THIS AREA. SEE GENERAL NOTE 16.

LEGEND

- FILTER CURTAIN
- SILT FENCE
- STONE FILL, TYPE I
- PDF — PROJECT DEMARCATION FENCE (SNOW FENCE (MOD.-PDF))
- STONE CHECK DAM (TEMP.) (TO BE REMOVED UPON COMPLETION OF STONE DITCHES.)

FOR RIGHT OF WAY
INFORMATION
ONLY

EXISTING BRIDGE DATA

BRIDGE WIDTH: 5151
BRIDGE LENGTH: 13.716
ROADWAY APPROACH WIDTH: 3962
THE EXISTING BRIDGE IS A PONY TRUSS WITH A WOOD PLANK DECK WITH RUNNERS. THERE IS A ROLLED BEAM STRINGER AT EACH FASCIA WITH FOUR H-PILES IN BETWEEN SUPPORTING THE DECK. THE EXISTING ABUTMENTS ARE CONCRETE WITH METAL I-BEAM BACKWALLS.

LINES SHOWN ON THIS PLAN AS EXISTING PROPERTY LINES P/L ARE BELIEVED TO BE ACCURATE BUT SHOULD NOT BE RELIED UPON FOR PURPOSES UNRELATED TO THE TOWN OF MONTGOMERY'S ACQUISITION OF LAND AND RIGHTS FOR THIS PROJECT.

0 10 20
SCALE 1:250

SHEET NAME: PLAN SHEET

PROJECT NAME: MONTGOMERY
PROJECT NUMBER: BRO 1448(20)
HIGHWAY NO.: TH 35
BRIDGE NO.: 24
OVER: PACIFIC BROOK

FILE NAME: /PW/94J124/sj124bdr.dgn
PROJECT MANAGER: R. WHITCOMB
DESIGNED BY: C. CARLSON
R. O. W. SHEET 7 OF 7 SHEETS
PLOT DATE: 06-DEC-2005
DRAWN BY: J. GILMORE
IPARM NAME: sj124lal.i
SHEET 6 OF 50