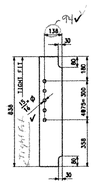

CONN. PLATE MK. x1a

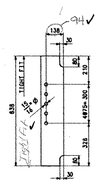

CONN. PLATE MK. x1b

PROJECT NO.	STATE	PROJECT ACCT. NO.
	VT	

BILL OF MATERIAL

SHIP	QTY. EA.	MARK	COMM.	DESCRIPTION				LENGTH	SPEC	GRADE	TEST	REMARKS	GRP.	ITEM	PIECE WEIGHT EA. (KG)
1	16	x1a	FL	13	x	178		836	M270M	345W			7	1	15.22
1	8	x1b	FL	13	x	178		838	M270M	345W			7	1	15.22

RECEIVED

OK'D BY MH OK'D BY CWC

MAR 17 2006

RESUBMIT ____ APPROVED AS NOTED

BY CWC DATE 4-11-06

NO.	REVISION	BY	DATE
△			
△			
△			

HIGH STEEL STRUCTURES, INC.

1470 Hampshire Road
Lancaster, PA 17601-1068
Phone: 717-397-1011

A Division of High Industries, Inc.

GIRDER JOB STANDARDS

RTE. NO. IH 35 (BRIDGE NO. 241 OVER PACIFIC BROOK

RTE. NO. IH 35 STA. 14685.800 TO STA. 14112.300

TOWN OF MONTGOMERY

FRANKLIN COUNTY, VERMONT

STATE OF VERMONT, AGENCY OF TRANSPORTATION

STATE CONTROL OF RW - NO. ____ PROJECT NO. BRO 1448 (38)

CONTRACTOR A.L. ST. ONGE CONTRACTOR, INC.

IN CHARGE BRITTIGAN (20) DATE ____ BY BC CHK'D BY MGK DATE 3/2/06

CONTRACT NUMBER VT-0600 1-1 CONTRACT SHEET NO. X1 OF X2

NOTES:

HOLES: AS NOTED

BOLTS: NONE

PAINT: NONE

FOR GENERAL SHOP NOTES, SEE DWG. GN1.

CODE: 30

06 5 SS

06001 X1 3/9/06 3/9/06Approval TO:A.L. St. Onge Contractor,