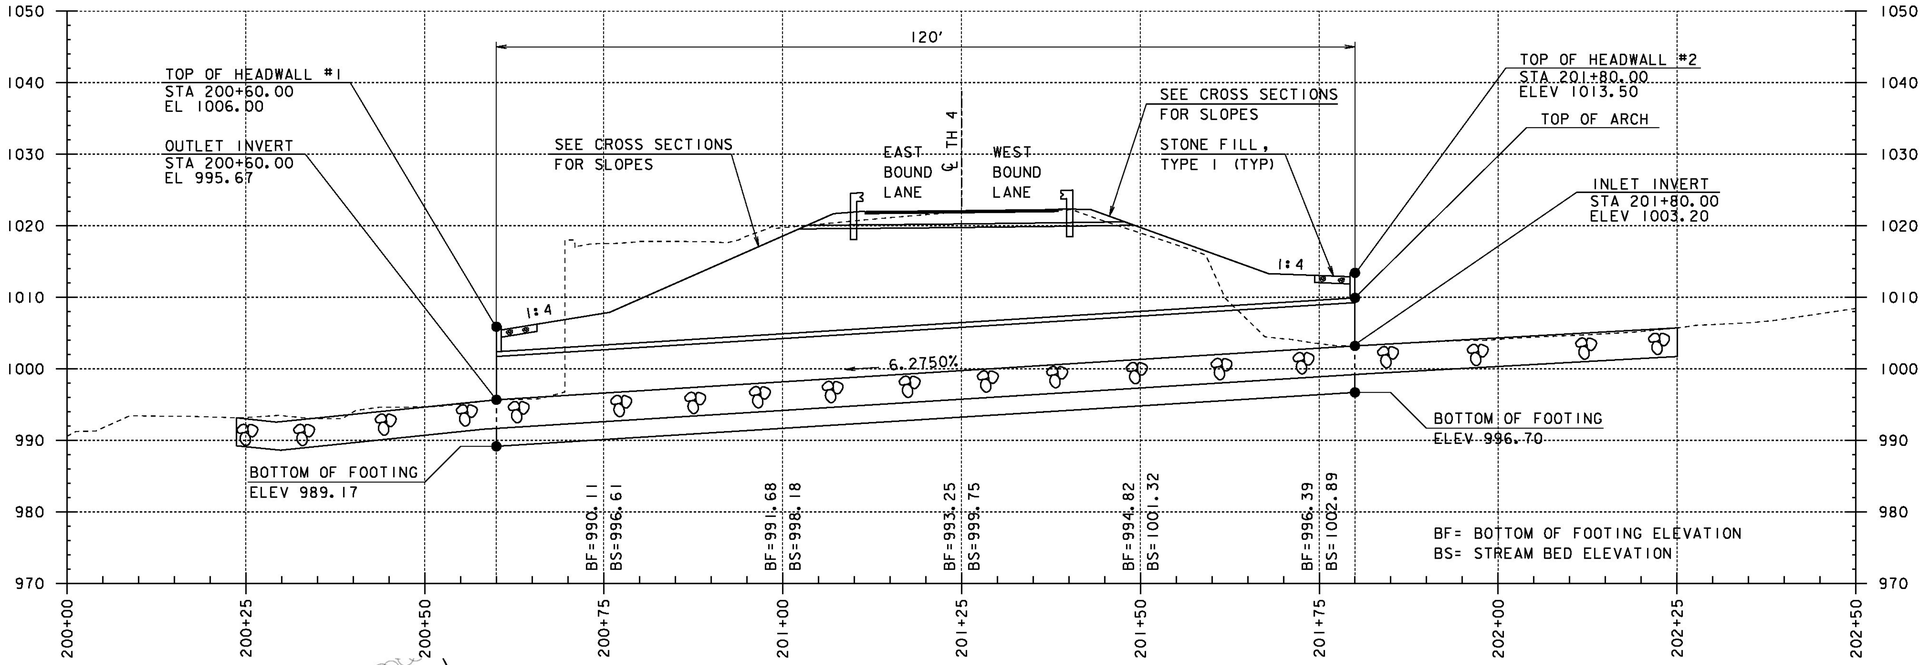

CONCRETE ARCH PROFILE

HORIZONTAL & VERTICAL SCALE: 1"=10'-0"

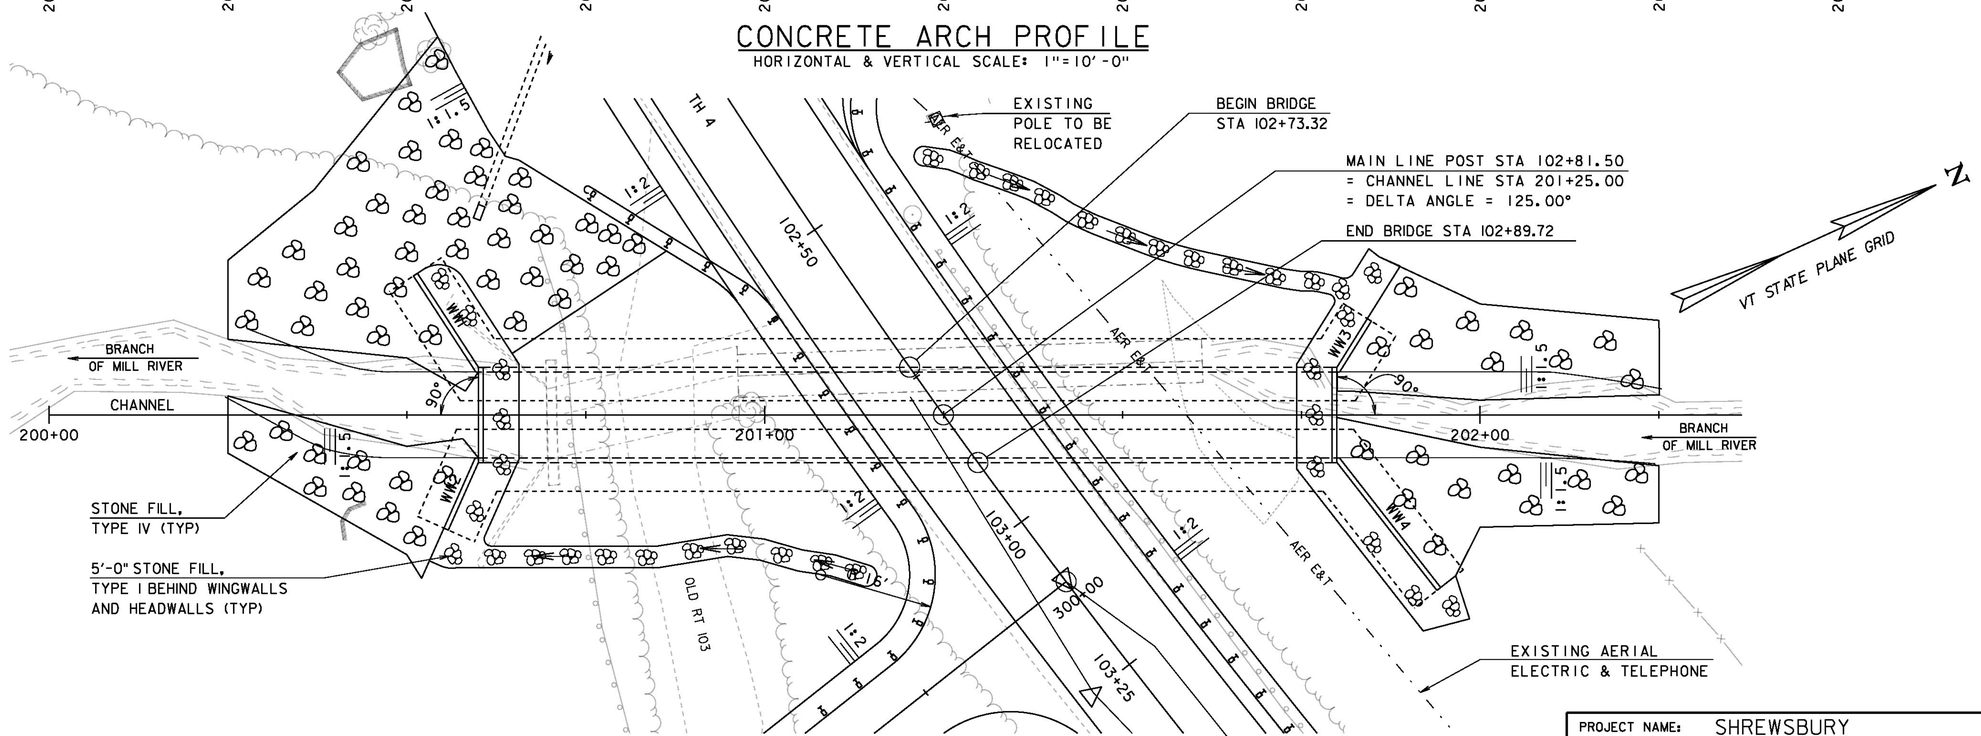

CONCRETE ARCH PLAN

SCALE: 1" = 10'-0"

10 0 10

PROJECT NAME:	SHREWSBURY
PROJECT NUMBER:	STP 1443 (44)

FILE NAME: s941j54pp.dgn	PLOT DATE: 12-MAY-2014
PROJECT LEADER: C. CARLSON	DRAWN BY: M. LONGSTREET
DESIGNED BY: N. VANDENBERG	CHECKED BY: J. LACROIX
CONCRETE ARCH PLAN & PROFILE	SHEET 19 OF 36