STATE OF VERMONT
AGENCY OF TRANSPORTATION

TRAFFIC SIGN SUMMARY SHEET

MILE MARKER, STATION OR SIGN NUMBER	SIGN LEGEND	SIGN DIMENSIONS			NEW & SALVAGED SIGNS				EXIST POST		NEW SIGN POSTS																						REMARKS	SIGN DETAIL	
		EACH	WIDTH (mm)	HEIGHT (mm)	"A"	"B"	SALV SIGN	SALV TIS	RETAIN	SALVAGE	NO. OF POST	FLANGED CHANNEL (kg / m)			SQUARE STEEL (mm) (kg / m)			ANCHOR	SLEEVE	TUBULAR ALUMINUM Ø (mm) (kg / m)			FOUNDATION	TUBULAR STEEL Ø (mm) (kg / m)				W-SHAPE STEEL				SIGN FRAME REQUIRED		DETAIL ON SHEET NUMBER	STANDARD SHEET NUMBER
																												FTG. SIZE		WEIGHT	POST SIZE				
												1.7	3.0	4.5	3.4	3.6	5.0			1.9	2.5	2.5		11.3	13.4	16.1	21.7	600 mm	750 mm						
															44	50	63			75	100	100 MOD		75	89	100	125								
OPTION ITEMS																																				
ML 1+080 RT		1	750	750	0.56						1					X 4.57		1															W3-1		SHS
ML 1+098 LT		1	600	750	0.45						1					X 2.90		1															R2-1		SHS
ML 1+114 RT		1	150	200	0.03						1				X	2.13		1															VD-701		E-134
ML 1+158 LT		1	150	200	0.03																												VD-701		E-134
		1	150	250	0.04						1				X	1.98		1																	E-138
ML 1+189 RT	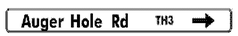	1	~~1550~~ 1525	~~300~~ 200	~~0.47~~ 0.31																												D3-1	18	
ML 1+189 RT		1	~~1150~~ 1525	~~300~~ 200	~~0.35~~ 0.31																												D3-1	18	
ML 1+189 RT		1	750	750	0.56																												R1-1		SHS
ML 1+189 RT		1	450	150	0.07						2					4.42 X 4.42		1															R1-4		SHS
												m .	m .	m .	m 6.75	m 27.7	m .		EA .	kg .	kg .	kg .		kg .	kg .	kg .	kg .								
	SUB-TOTALS				m2 ~~2.55~~ 2.36	m2 .	EA. .	m2 .				m .			m ~~34.5~~ 20.42					kg .			EA. .	kg .				EA. .	EA. .	kg .					

FINAL POST LENGTHS ARE TO BE DETERMINED IN THE FIELD. POST SIZES ARE COMPUTED BASED ON INFORMATION FURNISHED ON THE STANDARD SHEETS AND THE VTRANS "SIGN POST DESIGN GUIDELINE."

PROJECT NAME: **NEWFANE**
PROJECT NUMBER: **BRF 0106(3)S**

FILE NAME: **s95j280tss.dgn**
PROJECT MANAGER: **C. CARLSON**
DESIGNED BY: **T. LACKEY**
TRAFFIC SIGN SUMMARY SHEET 1

PLOT DATE: **29-JUL-2011**
DRAWN BY: **T. LACKEY**
CHECKED BY: **C. CARLSON**
SHEET **20** OF **70**