STATE OF VERMONT
AGENCY OF TRANSPORTATION

TRAFFIC SIGN SUMMARY SHEET

MILE MARKER, STATION OR SIGN NUMBER	SIGN LEGEND	SIGN DIMENSIONS			NEW & SALVAGED SIGNS				EXIST POST		NEW SIGN POSTS																						REMARKS	SIGN DETAIL	
		EACH	WIDTH (mm)	HEIGHT (mm)	"A"	"B"	SALV SIGN	SALV TIS	RETAIN	SALVAGE	NO. OF POST	FLANGED CHANNEL (kg / m)			SQUARE STEEL (mm) (kg / m)			ANCHOR	SLEEVE	TUBULAR ALUMINUM Ø (mm) (kg / m)			FOUNDATION	TUBULAR STEEL Ø (mm) (kg / m)				W-SHAPE STEEL						DETAIL ON SHEET NUMBER	STANDARD SHEET NUMBER
															44	50	63			75	100	100 MOD		75	89	100	125	FTG. SIZE 600 mm	FTG. SIZE 750 mm	WEIGHT	POST SIZE	SIGN FRAME REQUIRED			
												1.7	3.0	4.5	3.4	3.9	5.0			1.9	2.5	2.5		11.3	13.4	16.1	21.7								
OPTION ITEMS																																			
TH3 ~~3+018~~ RT 2+960 RT		1	750	750	0.56						1					X 4.50																	W3-1		SHS
TH3 3+075 RT		1	1525 ~~1250~~	200 ~~225~~	0.31 ~~0.28~~																												D3-1	18	
TH3 3+075 RT		1	750	750	0.56																												R1-1		SHS
TH3 3+075 RT		1	600	230	0.14																												R1-4		SHS
TH3 3+075 RT		1	150	250	0.04						2				X	4.42 4.27																		E-138
TH3 3+100 LT		1	1525 ~~1500~~	200 ~~225~~	0.31 ~~0.34~~																												D3-1	18	
TH3 3+100 LT	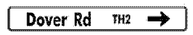	1	1525 ~~1150~~	200 ~~225~~	0.31 ~~0.26~~																												D3-1	18	
TH3 3+100 LT		1	750	750	0.56																												R1-1		SHS
TH3 3+100 LT		1	600	230	0.14						2					4.65 X 4.72																	R1-4		SHS
TH3 3+112 RT		1	600	750	0.45						1					X 4.11																	R2-1		SHS
TH3 3+160 LT		1	750	750	0.56						1					X 4.27																	W3-1		SHS
												m .	m .	m .	m ~~7.~~	m ~~38.1~~	m .		EA .	kg .	kg .	kg .		kg .	kg .	kg .	kg .								
GRAND-TOTALS					m2 2.36 ~~6.44~~	m2 .	EA. .	m2 .				m .			m ~~77.5~~ 30.94					kg .			EA. .	kg .				EA. .	EA. .	kg .					

FINAL POST LENGTHS ARE TO BE DETERMINED IN THE FIELD. POST SIZES ARE COMPUTED BASED ON INFORMATION FURNISHED ON THE STANDARD SHEETS AND THE VTRANS "SIGN POST DESIGN GUIDELINE."

PROJECT NAME: **NEWFANE**
PROJECT NUMBER: **BRF 0106(3)S**

FILE NAME: **s95j280tss.dgn** PLOT DATE: **29-JUL-2011**
PROJECT MANAGER: **C. CARLSON** DRAWN BY: **T. LACKEY**
DESIGNED BY: **T. LACKEY** CHECKED BY: **C. CARLSON**
TRAFFIC SIGN SUMMARY SHEET 2 SHEET 21 OF 70