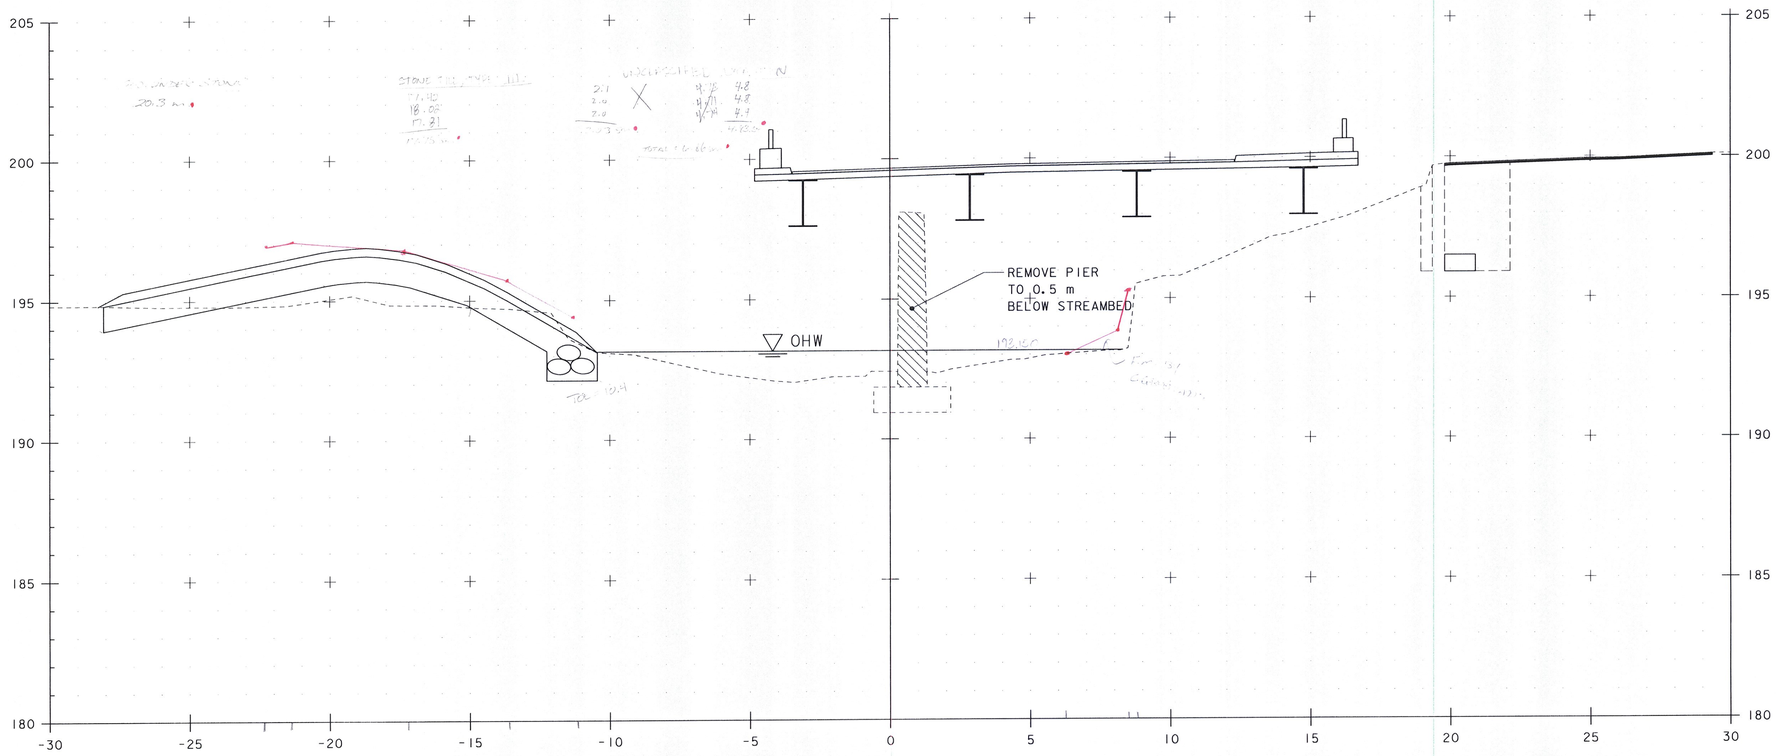

2+059 LT
END UNCLASSIFIED CHANNEL EXCAVATION
END STONE FILL, TYPE III
END GEOTEXTILE UNDER STONE FILL
END GRUBBING MATERIAL

2+055.00

2+056 RT
BEGIN STONE FILL, TYPE III

2+054 RT
BEGIN UNCLASSIFIED CHANNEL EXCAVATION
BEGIN STONE FILL, TYPE I
BEGIN GEOTEXTILE UNDER STONE FILL
BEGIN GRUBBING MATERIAL

STA. 2+055 TO STA. 2+055

PROJECT NAME: NEWFANE
PROJECT NUMBER: BRF 0106 (3)S

FILE NAME: s95J280xs.dgn
PROJECT MANAGER: C. CARLSON
DESIGNED BY: T. LACKEY
CHANNEL CROSS SECTIONS 4

PLOT DATE: 22-JUL-2011
DRAWN BY: C. MOONEY
CHECKED BY: G. SWEENY
SHEET 57 OF 70