Metric

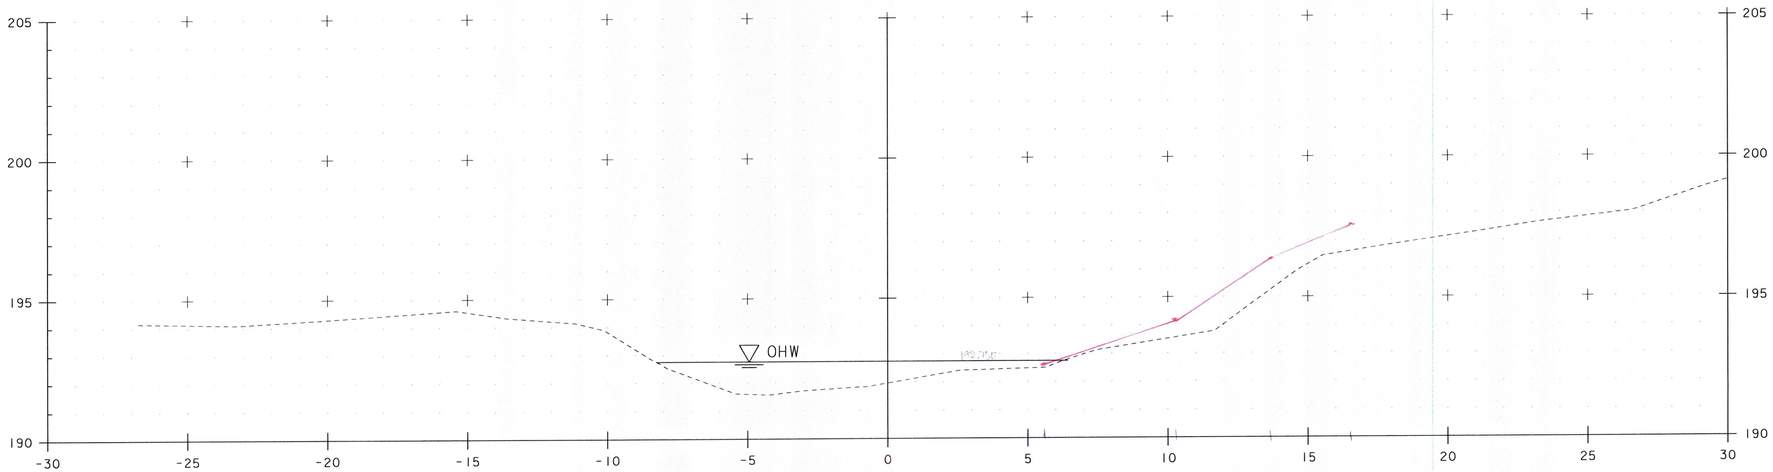

2+075.00

2+074.90 RT
END UNCLASSIFIED CHANNEL EXCAVATION
END STONE FILL, TYPE III
END GEOTEXTILE UNDER STONE FILL
END GRUBBING MATERIAL

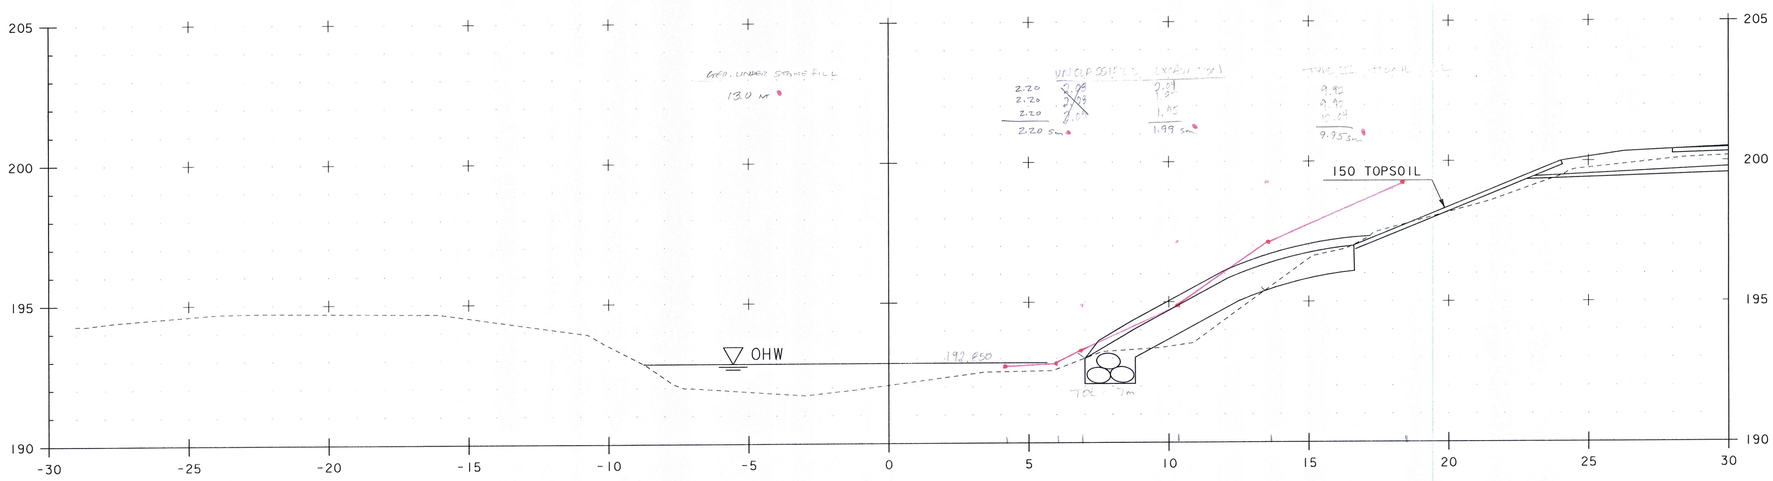

2+070.00

DAS 3/12/12

STA. 2+070 TO STA. 2+075

PROJECT NAME: NEWFANE	
PROJECT NUMBER: BRF 0106 (3)S	
FILE NAME: s95J280xs.dgn	PLOT DATE: 22-JUL-2011
PROJECT MANAGER: C. CARLSON	DRAWN BY: C. MOONEY
DESIGNED BY: T. LACKEY	CHECKED BY: G. SWEENY
CHANNEL CROSS SECTIONS 6	SHEET 59 OF 70