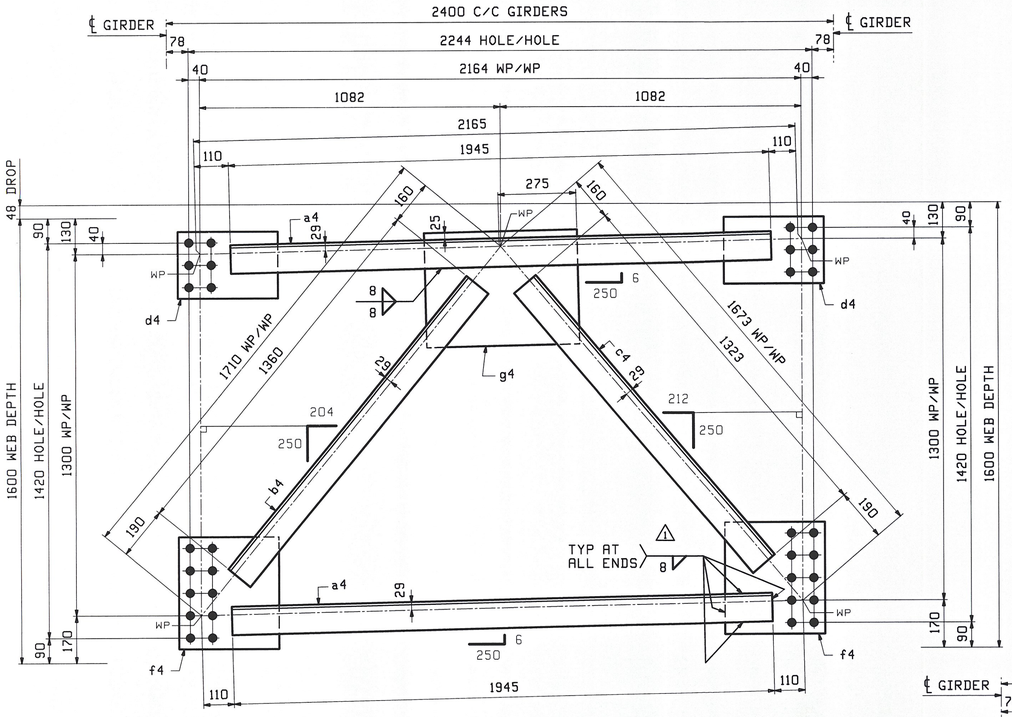

5 - CROSSFRAMES - 4CF1

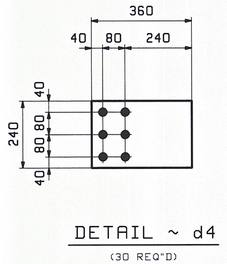

DETAIL ~ d4

(30 REQ'D)

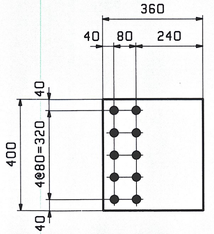

DETAIL ~ f4

(30 REQ'D)

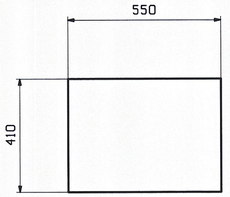

DETAIL ~ g4

(15 REQ'D)

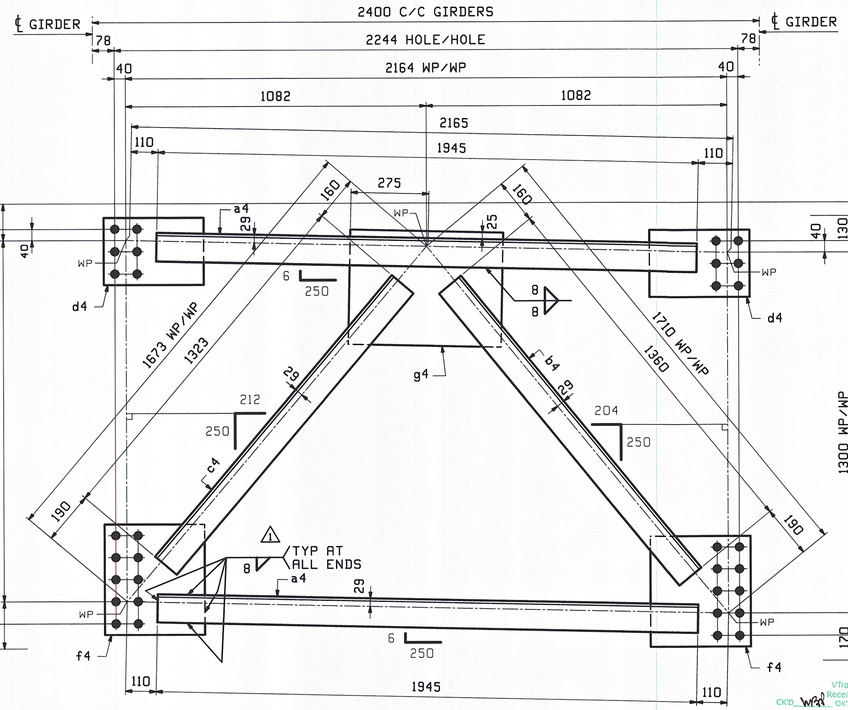

5 - CROSSFRAMES - 4CF2

ABM INFO		SHIP	BILL OF MATERIAL					JOB NO.	DRAWING NO.		REV.
								508	4		1
PAGE	LINE	MARK	QTY	MARK	MATERIAL	LENGTH m	LENGTH mm	REMARKS	WT	PROCUREMENT NOTES	
		4CF1	5		CROSSFRAMES				150 kg 330 lbs		
2	K		10	a4	L 102x102x9.5	1	945				
2	L		5	b4	L 102x102x9.5	1	360				
2	L		5	c4	L 102x102x9.5	1	323				
2	M		10	d4	PL 10x240	0	360				
2	N		10	f4	PL 10x360	0	400				
2	P		5	g4	PL 10x410	0	550				
		4CF2	5		CROSSFRAMES				150 kg 330 lbs		
2	K		10	a4	L 102x102x9.5	1	945				
2	L		5	b4	L 102x102x9.5	1	360				
2	L		5	c4	L 102x102x9.5	1	323				
2	M		10	d4	PL 10x240	0	360				
2	N		10	f4	PL 10x360	0	400				
2	P		5	g4	PL 10x410	0	550				

NOTE:
FOR GENERAL NOTES SEE DRAWING GN1.

REV.	DATE	REMARKS	DWN	CHK	APVL	SHOP
⚠1	11/1	ADDED HOLE SIZE NOTATION	PCP	PCP	11-30-11	

MATERIAL:	SURFACE PREP. & PAINT:	HOLES:	SHOP BOLTS:
M270M-345W	SEE DWG GN1	⚠1 24 mm	NONE

DESCRIPTION: CROSSFRAMES

CASCO BAY STEEL STRUCTURES, INC.
1 WALLACE AVE. PHONE (207) 780-6722
SOUTH PORTLAND, ME 04106 FAX. (207) 780-6726

TENSOR 3090

STRUCTURE:	VT TH 2 over MARLBORO BRANCH BRIDGE NO 14 NEWFANE County of Windham	DRAWN: TJB	DATE: 10/11
		CHK'D: PCP	DATE: 10/14
LOCATION:	Newfane	JOB NO.	DWG NO.
PROJ NO.	BRF 0106 (3)S	508	4
CUSTOMER:	VT AOT		REV. ⚠1

VTrans Received DEC 8 2011 CK'D WPP CK'd BY

Resubmit BY CWE APPROVED DATE 12-19-11

Mon, Nov 21, 2011 03:26:48 PM J:\steel\jobs\2010\4.dwg