PDF created with FinePrint pdfFactory trial version http://www.pdffactory.com

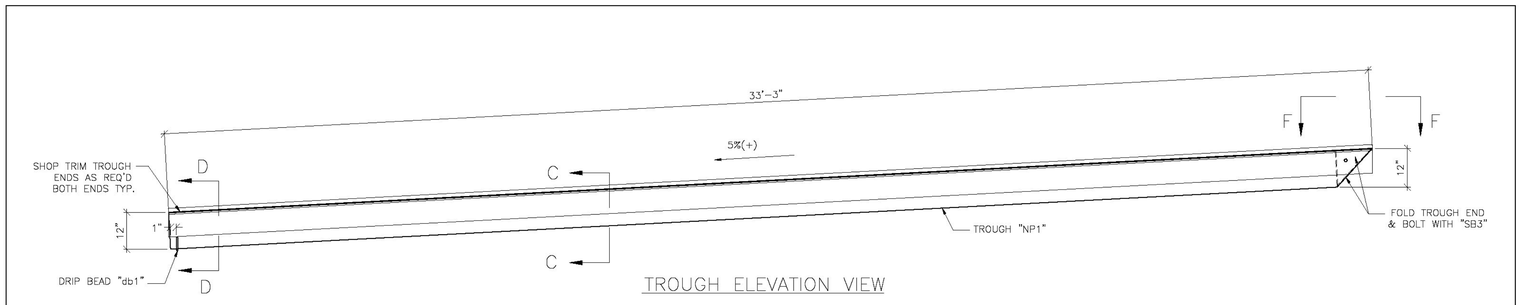

TROUGH ELEVATION VIEW

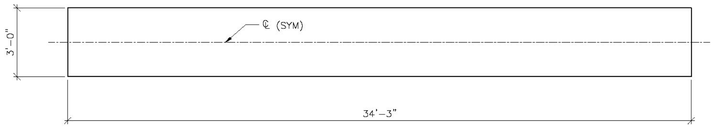

1 REQ'D, TROUGH MARK "NP1"
5/32" THK. PREFORMED FABRIC TROUGH (3 PLY)

SEE JOINT GAP DIMENSION TABLE ON SD-516.11b

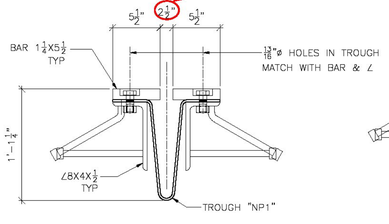

SECTION C–C

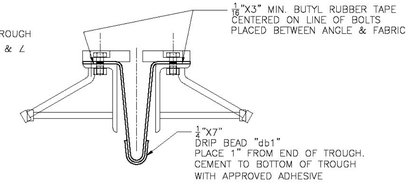

SECTION D–D

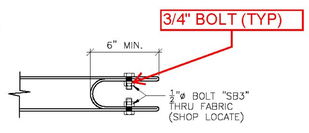

SECTION F–F

Vermont Agency of Transportation
RECEIVED
CK'D BY GML OK'D BY JTS
2:13 pm, Feb 22, 2012
RESUBMIT _____ APPROVED AS NOTED
BY KMH DATE 2-28-12

SEE DWG. 2 FOR B.O.M.

ERECTION BOLTS W/H.H.N.				WASHERS		FINISH
QUAN.	SIZE	LENGTH	TYPE	FLAT	BEV.	GALV. AASHTO M232

FINISH	HOT DIPPED GALVANIZED
MATERIAL	AASHTO M270 GR. 36
HOLES	AS NOTED
ELECTRODES	PER W.P.S.
WELDS	AS NOTED
SURFACE PREP	SSPC-SP6

NO	DATE	DESCRIPTION	BY
		REVISIONS	

ARC ENTERPRISES, INC.

ADVANCED RESOURCES & CONST. ENTERPRISES, INCORPORATED
P.O. BOX 120 KINGFIELD, ME. 04947
PHONE: (207) 265-2646 – FAX: (207) 265-4054

DRAFTER	JAC	TROUGH DETAILS	PROJECT NO.
DATE	2/9/12	VERMONT AGENCY OF TRANSPORTATION, TOWN OF SPRINGFIELD, TH 6 CLASS III, LOCAL ROAD	BRO 1442(28)
CHECKED	MTD	G.C. T. BUCK CONSTRUCTION, INC.	DWG. NO. 3
JOB	11-175		