Metric

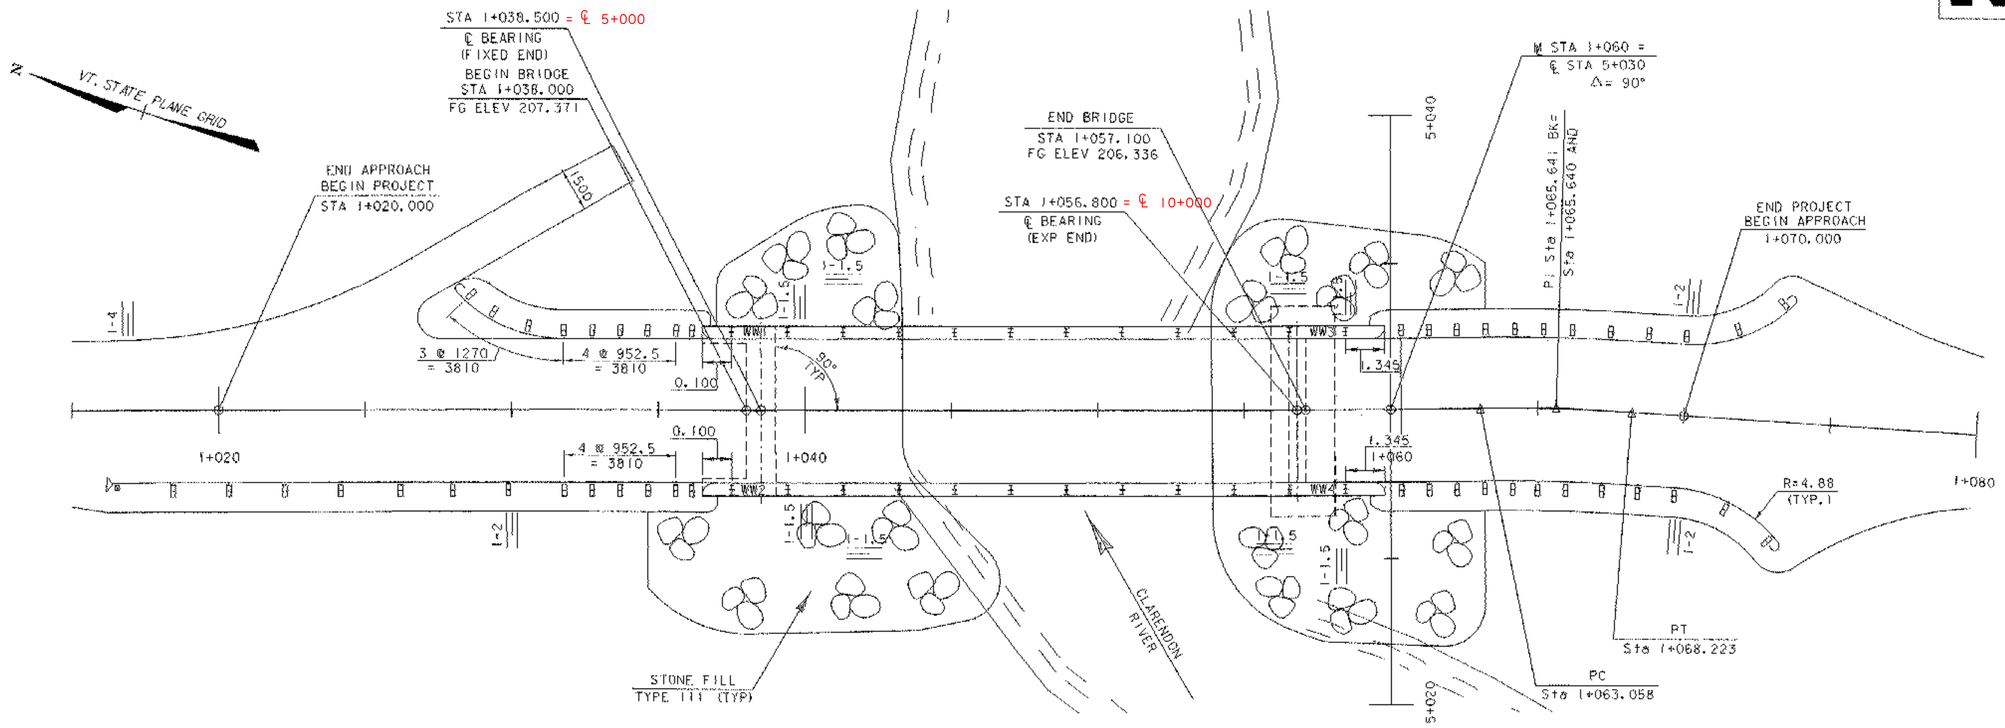

PLAN

0 1 2 4 6 8 10

SCALE = 1:100

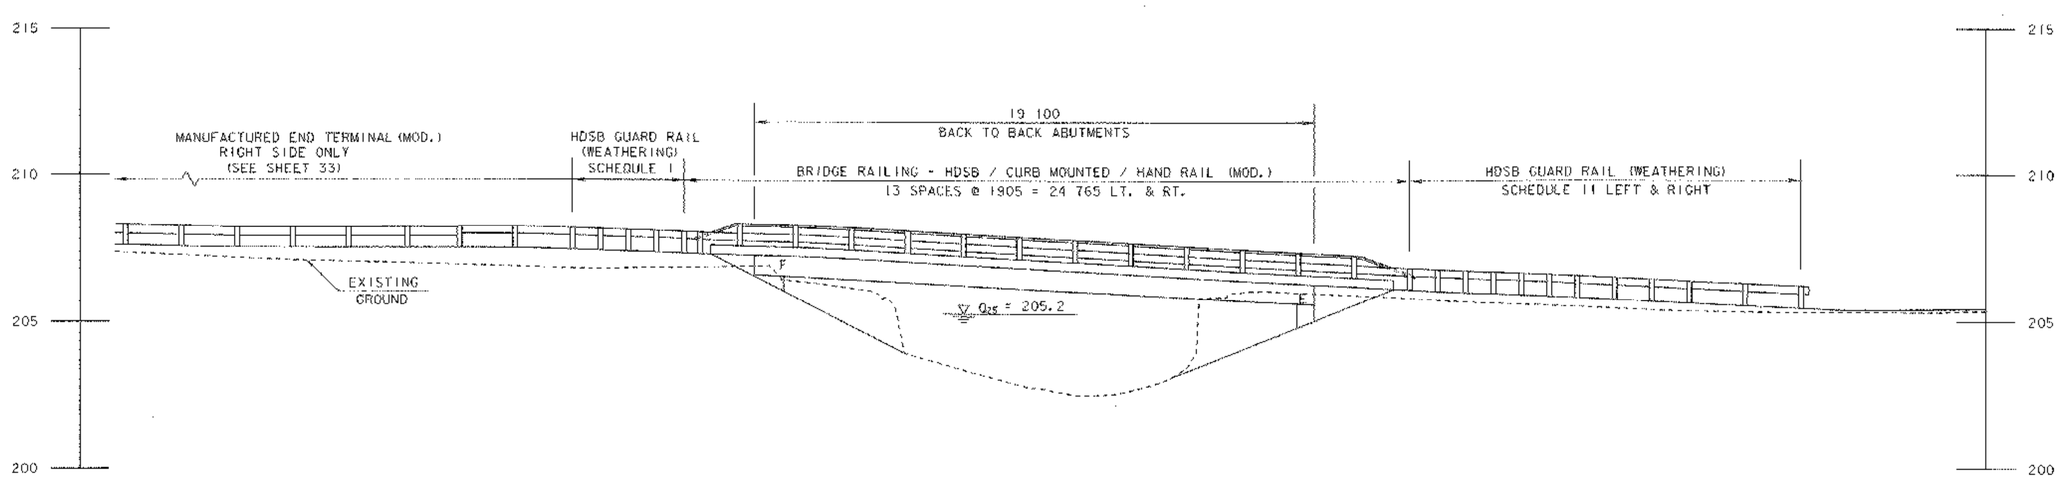

ELEVATION

0 1 2 4 6 8 10

SCALE = 1:100

SHEET NAME: PLAN AND ELEVATION SHEET	
PROJECT NAME: CLARENDON	HIGHWAY NO.: TH 16
PROJECT NUMBER: BRO 1443(34)	BRIDGE NO.: 24
	OVER: CLARENDON RIVER
FILE NAME: /PW/951286/sj286pe.dgn	PLOT DATE: 01-DEC-2005
PROJECT MANAGER: R. WHITCOMB	DRAWN BY: STRI
DESIGNED BY: C. CARLSON	IPARM NAME: sj286pe.I
BRIDGE SHEET NUMBER:	SHEET 16 OF 43