Metric

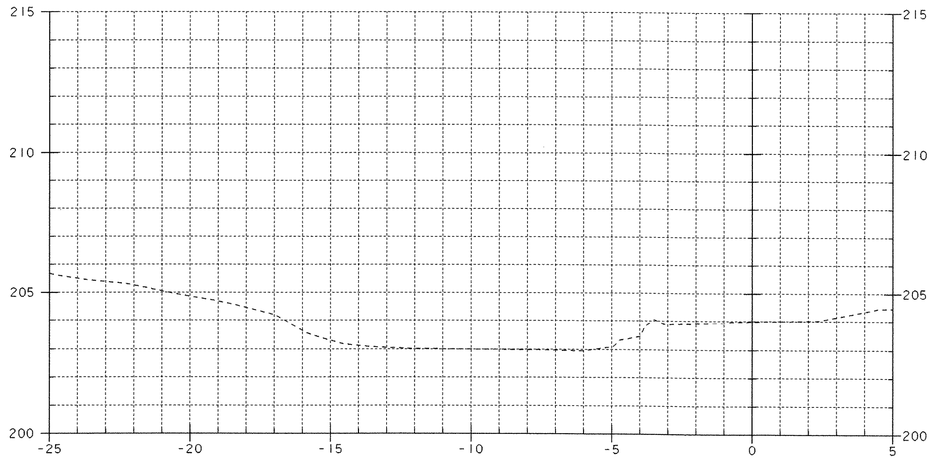

5+045

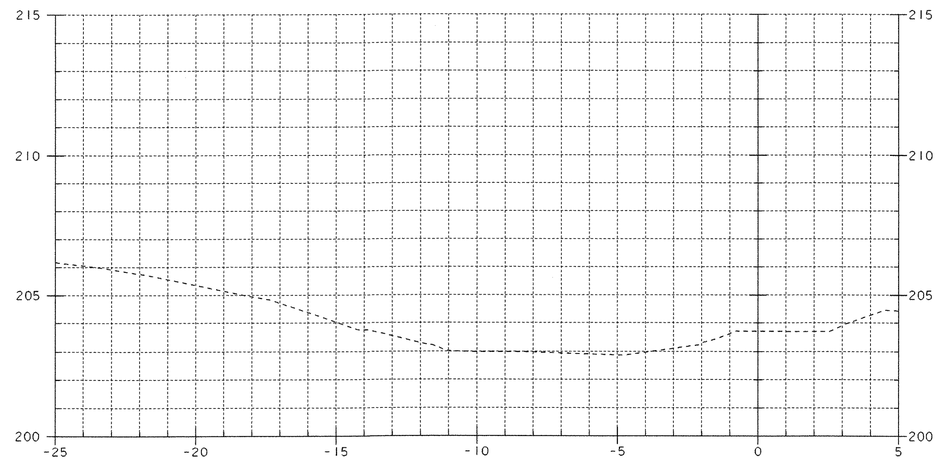

5+055

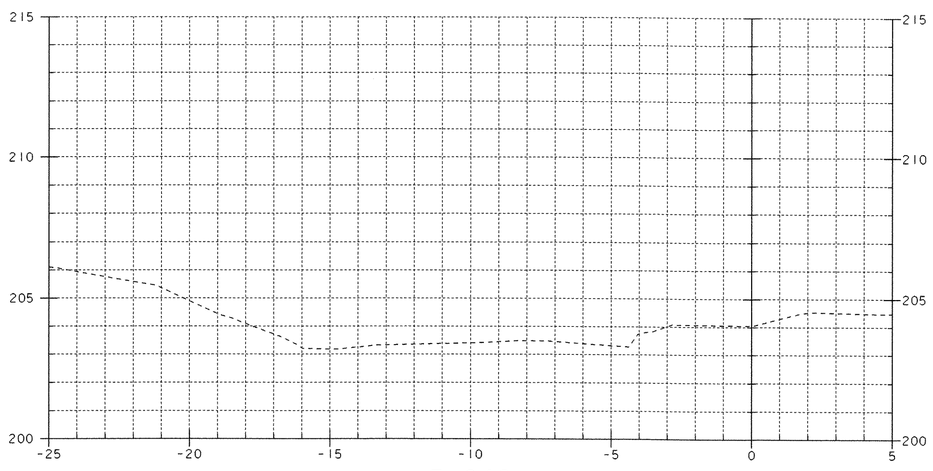

5+040

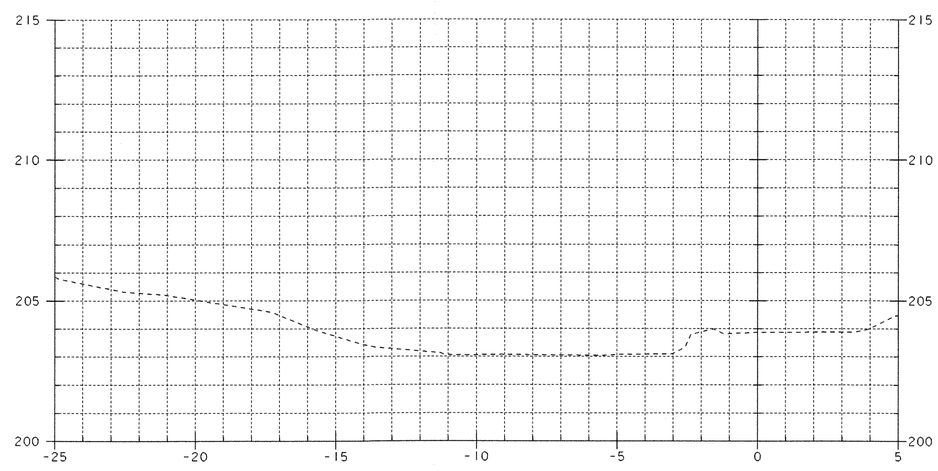

5+050

SHEET NAME: CHANNEL SECTIONS	
PROJECT NAME: CLARENDON PROJECT NUMBER: BRO 1443(34)	HIGHWAY NO.: TH 16 BRIDGE NO.: 24 OVER: CLARENDON RIVER
FILE NAME: /PW/95J286/sj286xsl.dgn PROJECT MANAGER: R. WHITCOMB DESIGNED BY: C. CARLSON BRIDGE SHEET NUMBER:	PLOT DATE: 01-DEC-2005 DRAWN BY: STRI IPARM NAME: sj286cx3.i SHEET 43 OF 43