Metric

CONSTRUCT DRIVES

DRIVE LEFT
STA 0+959.740 (PAVED APRON)

150mm UNDERDRAIN
~~STA 0+994.330 LT - STA 1+015.000 LT~~
~~STA 0+999.720 RT - STA 1+015.000 RT~~

30.48m INSTALLED PARALLEL TO TRACKS BY RxR REPRESENTATIVE

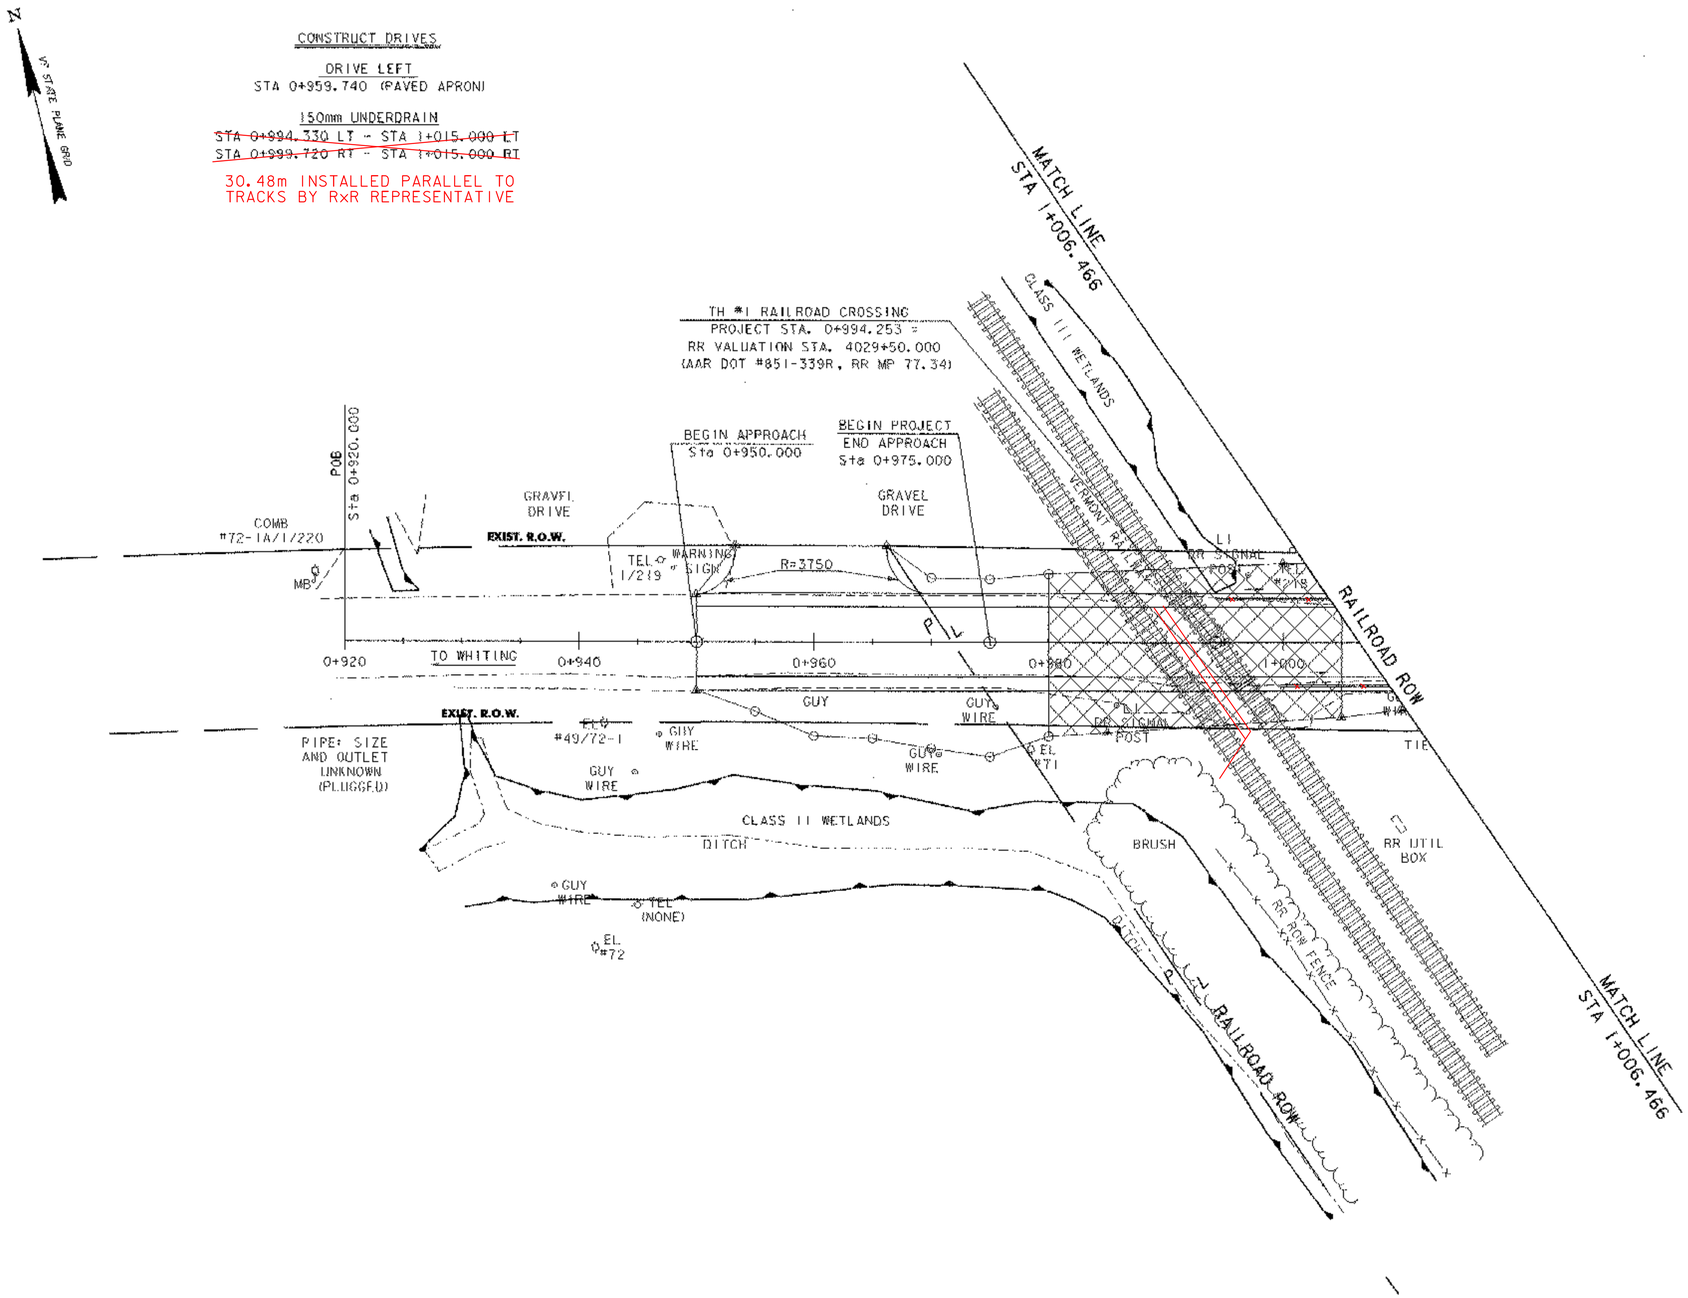

INDICATES APPROXIMATE RAILROAD WORK AREA. WORK IN THIS AREA TO BE PERFORMED BY VERMONT RAILWAY. SEE PROJECT NOTE 16 ON SHEET 47 AND SHEET 38a FOR ADDITIONAL INFORMATION.

SEE LINE STRIPING AND SIGN LAYOUT ON SHEET 36.

0 10 20
SCALE 1:250

SHEET NAME:	PLAN LAYOUT #1		
PROJECT NAME:	LEICESTER	HIGHWAY NO.:	FAS 0160
PROJECT NUMBER:	BRF 0160(3)S	BRIDGE NO.:	6
		OVER:	OTTER CREEK
FILE NAME: 95j288\Structures\sj288bdr.dgn		PLOT DATE:	17-AUG-2005
PROJECT MANAGER: R. R. WHITCOMB		DRAWN BY:	J. GILMORE
DESIGNED BY:	C. CARLSON	PARM NAME:	sj088psl.l
BRIDGE SHEET NUMBER:		SHEET	11 OF 90