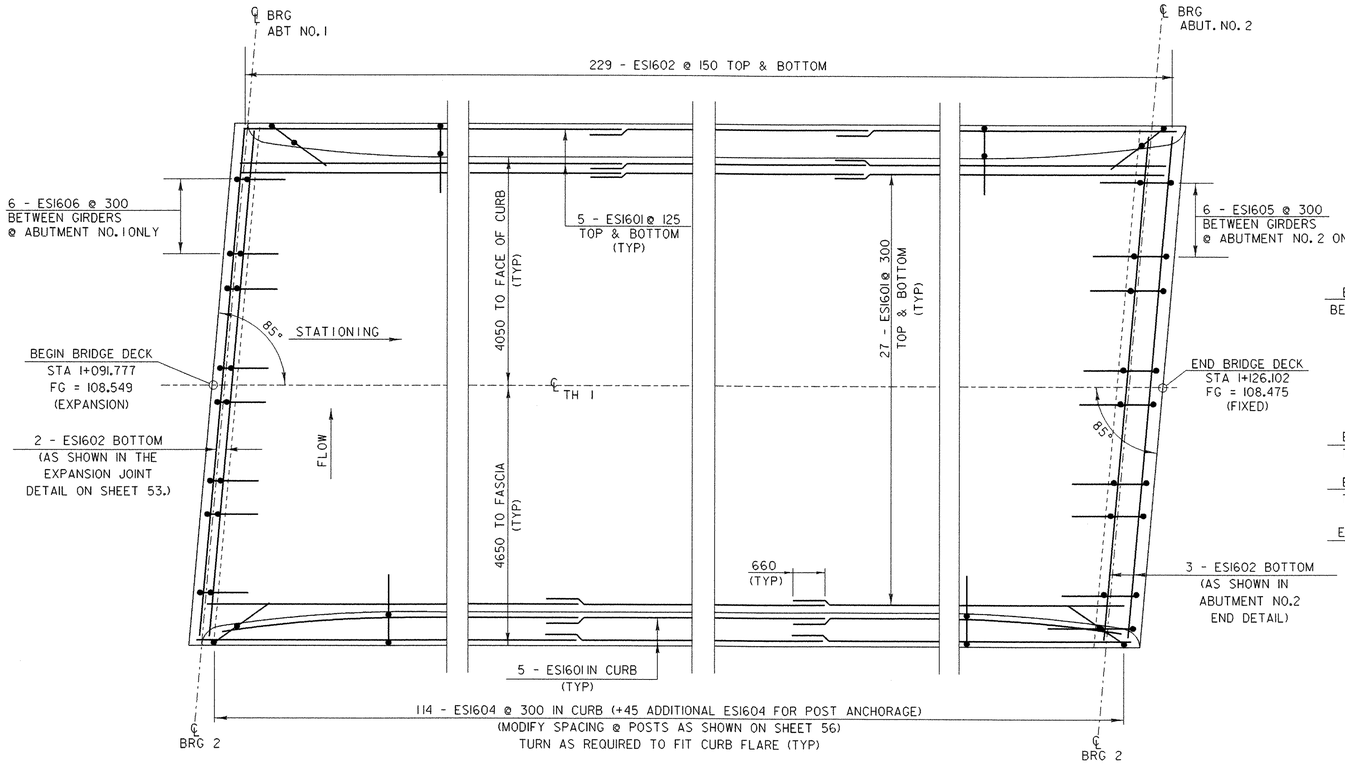

DETAIL REINFORCING PLAN

SCALE 1 : 50

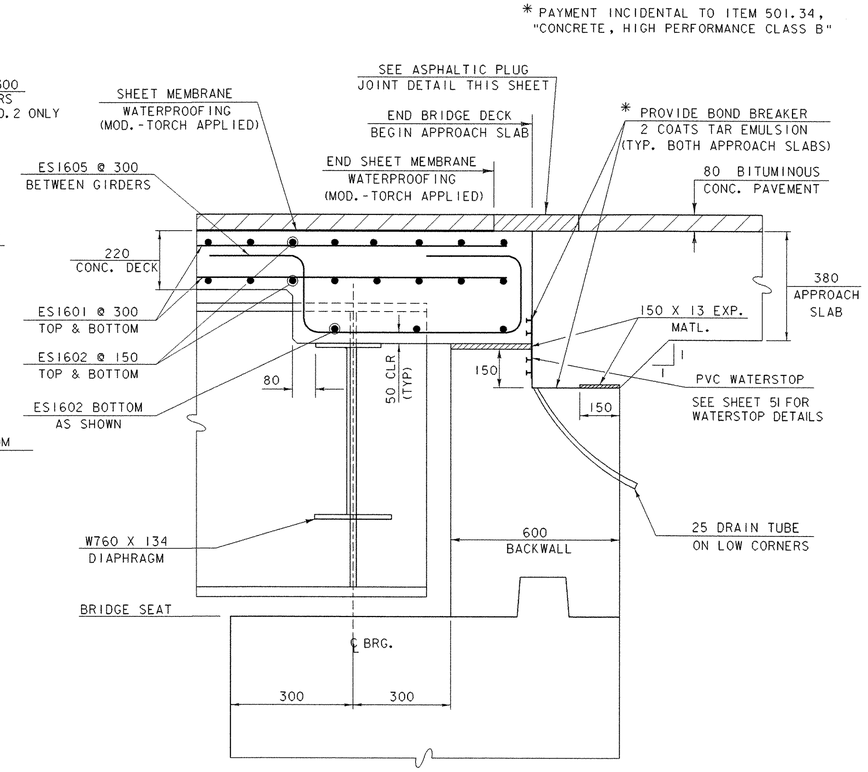

END DETAIL @ ABUTMENT NO. 2

NORMAL TO CENTERLINE OF BEARING
NOT TO SCALE

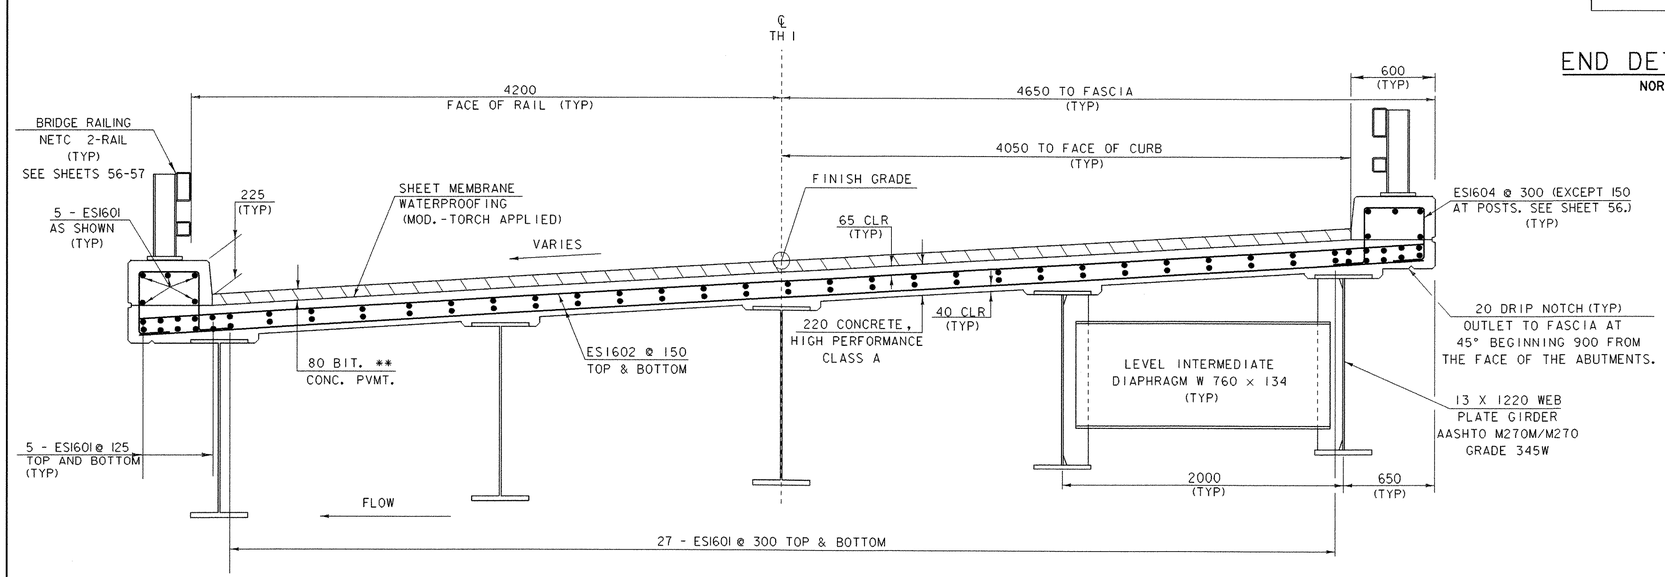

BRIDGE TYPICAL SECTION

SCALE 1 : 20

** 40 BIT. CONC. PVMT. TYPE III OVER
40 BIT. CONC. PVMT. TYPE III

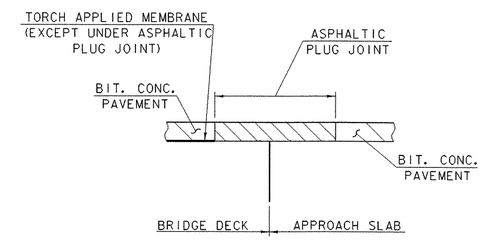

ASPHALTIC PLUG JOINT DETAIL

NOT TO SCALE

SHEET NAME: DECK REINFORCING PLAN	
PROJECT NAME: LEICESTER PROJECT NUMBER: BRF 0160(3)S	HIGHWAY NO.: TH 1 BRIDGE NO.: 6 OVER: OTTER CREEK
FILE NAME: 95J288\Structures\sj288sup.dgn PROJECT MANAGER: R. R. WHITCOMB DESIGNED BY: C. CARLSON BRIDGE SHEET NUMBER:	PLOT DATE: 17-AUG-2005 DRAWN BY: T. FILLBACH IPARM NAME: sj288dck.I SHEET 48 OF 90