STATE OF VERMONT
AGENCY OF TRANSPORTATION

PROPOSED IMPROVEMENT
BRIDGE PROJECT

TOWN OF WOODSTOCK
COUNTY OF WINDSOR

ROUTE NO : TH 6, LOCAL CLASS 2 BRIDGE NO : 23

PROJECT LOCATION: APPROXIMATELY 0.54 MILES WEST OF THE INTERSECTION OF VT 12 AND TH 6 (N. BRIDGEWATER ROAD) AND EXTENDING EASTERLY ALONG TH 6 FOR 125 FEET.

PROJECT DESCRIPTION: REPLACEMENT OF EXISTING BRIDGE WITH A PRECAST CONCRETE STRUCTURE ALONG WITH RELATED ROADWAY AND CHANNEL WORK.

LENGTH OF STRUCTURE: 34.00 FEET
LENGTH OF ROADWAY: 91.00 FEET
LENGTH OF PROJECT: 125.00 FEET

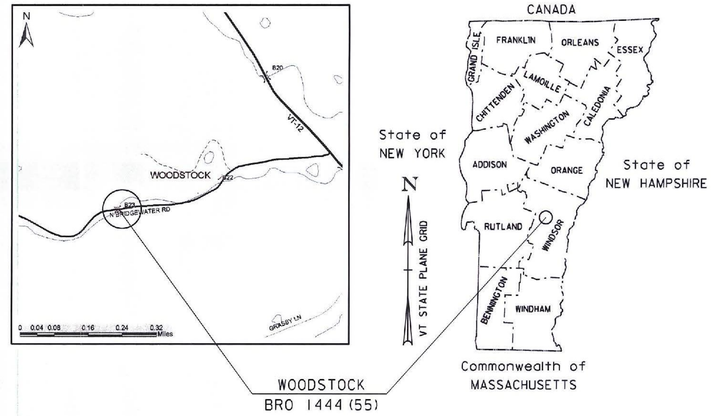

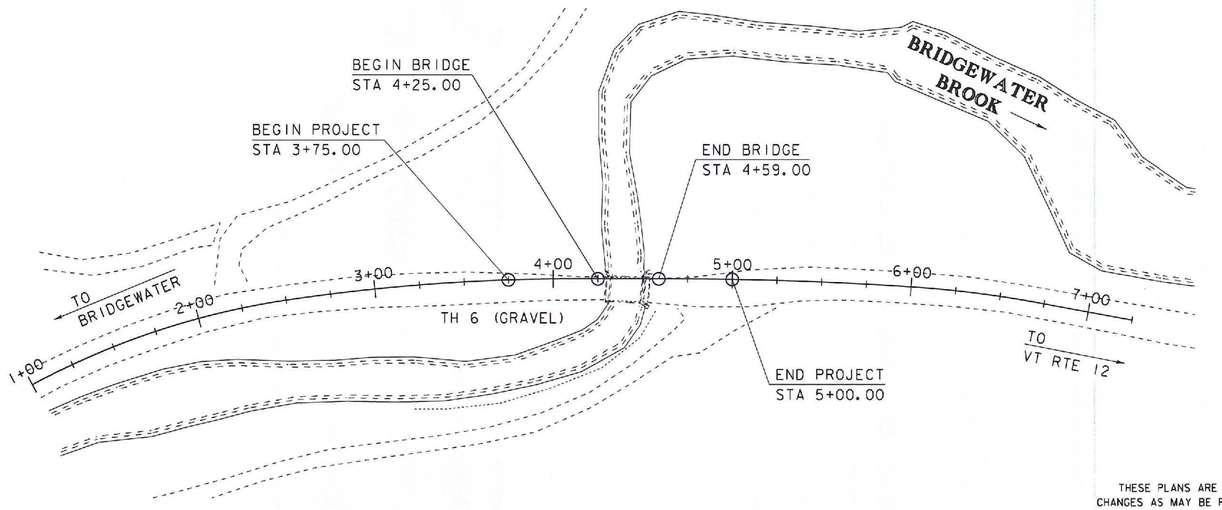

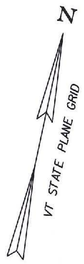

40 0 40
SCALE: 1" = 40'-0"

RECORD PLANS

CONTRACTOR: B.U.R. CONSTRUCTION, LLC, CLAREMONT, NH
RESIDENT ENGINEER: RYAN DARLING
CONSTRUCTION BEGAN: JUNE 25, 2013
CONSTRUCTION COMPLETE: AUGUST 30, 2013
RECORD PLANS BY: RYAN DARLING & KEVIN KING

I HEREBY CERTIFY THAT ALL THE CONSTRUCTION REQUIRED BY THIS SET OF DRAWINGS HAS BEEN ACCOMPLISHED AS INDICATED HEREIN.

BY Ryan Darling RESIDENT ENGINEER
DATE 1/9/2014

NOTE: Any further information concerning final quantities, amounts or other details relative to this project may be found at Central Files in the electronic archives.

QUALITY ASSURANCE PROGRAM: LEVEL 2

CONVENTIONAL SYMBOLS

COUNTY LINE
TOWN LINE
LIMITS OF ACCESS
POINT OF ACCESS
FENCE LINE
STONE WALL
TRAVELED WAY
GUARD RAIL
RAILROAD
SURVEY LINE
CULVERT
POWER POLE
TELEPHONE POLE
TREES
CONTROL OF ACCESS
PROPERTY LINE
R.O.W. TAKING LINE
SLOPE RIGHTS (SR SR SR)
TOP OF CUT
TOE OF SLOPE

SURVEYED BY : R. BULLOCK
SURVEYED DATE : 11/05/1996

DATUM
VERTICAL NAVD88
HORIZONTAL NAD83(92)

THESE PLANS ARE SUBJECT TO SUCH ENGINEERING CHANGES AS MAY BE REQUIRED BY THE FEDERAL HIGHWAY ADMINISTRATION OR THE DIRECTOR OF PROGRAM DEVELOPMENT.

CONSTRUCTION IS TO BE CARRIED ON IN ACCORDANCE WITH THESE PLANS AND THE STANDARD SPECIFICATIONS FOR CONSTRUCTION DATED 2011, AS APPROVED BY THE FEDERAL HIGHWAY ADMINISTRATION ON JULY 20, 2011 FOR USE ON THIS PROJECT, INCLUDING ALL SUBSEQUENT REVISIONS AND SUCH REVISED SPECIFICATIONS AND SPECIAL PROVISIONS AS ARE INCORPORATED IN THESE PLANS.

PLOTTED 13-FEB-2013

DIRECTOR OF PROGRAM DEVELOPMENT
APPROVED Richard Tetreault DATE 2-13-13

PROJECT MANAGER : K.M. HIGGINS

PROJECT NAME : WOODSTOCK
PROJECT NUMBER : BRO 1444(55)

SHEET 1 OF 28 SHEETS