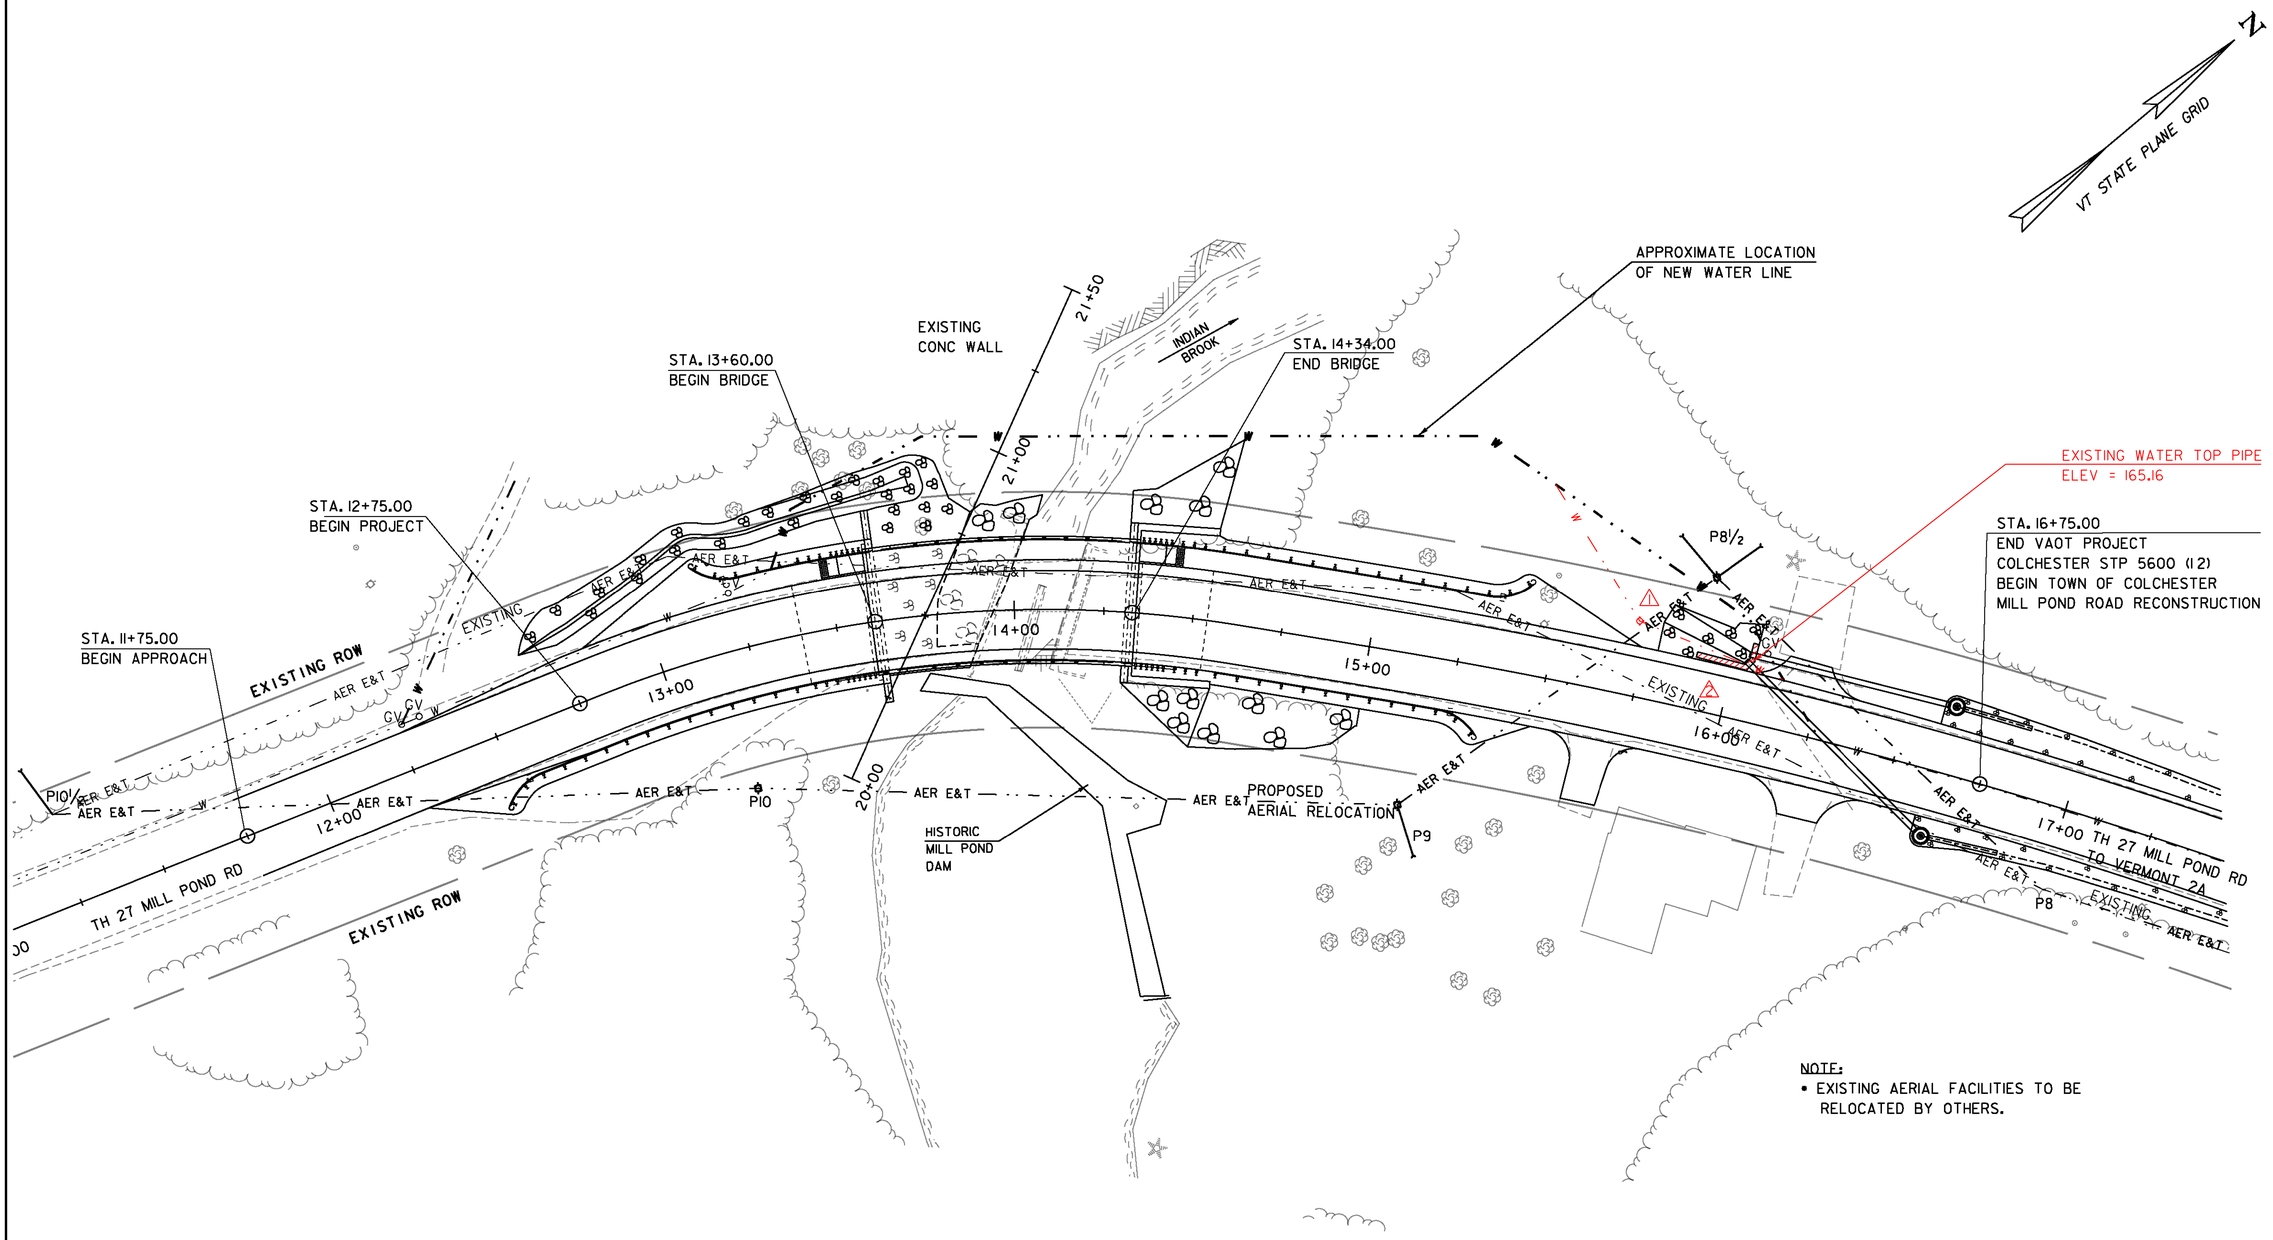

NOTE:
- EXISTING AERIAL FACILITIES TO BE RELOCATED BY OTHERS.

KEY	DATE	BY	REVISION
1	05/15/2015	VAOT	HYDRANT @ 15+70 LT. BY OTHERS
2	04/21/2015	VAOT	HEADWALL ELIMINATED

SCALE 1" = 20'-0"
20 0 20

PROJECT NAME: COLCHESTER
PROJECT NUMBER: STP 5600 (12)

FILE NAME: s95j298utilbdr.dgn
PROJECT LEADER: C. CARLSON
DESIGNED BY: N. VANDERBERG
UTILITIES LAYOUT

PLOT DATE: 26-JAN-2015
DRAWN BY: G. ROKES
CHECKED BY: D. PETERSON
SHEET 14 OF 53