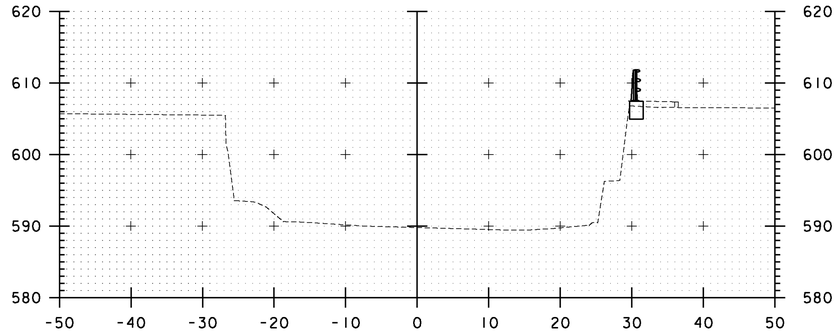

32+75

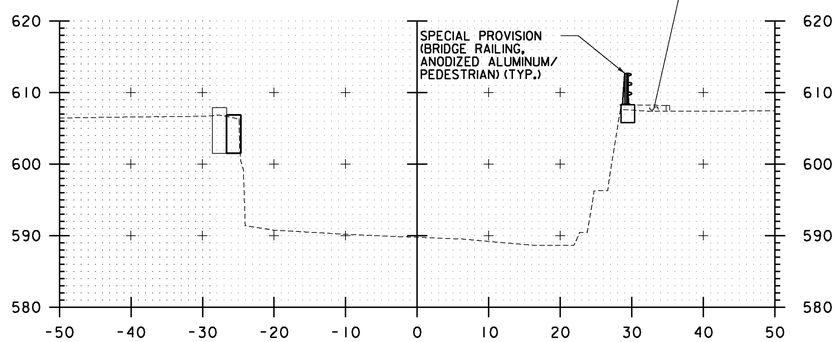

32+50

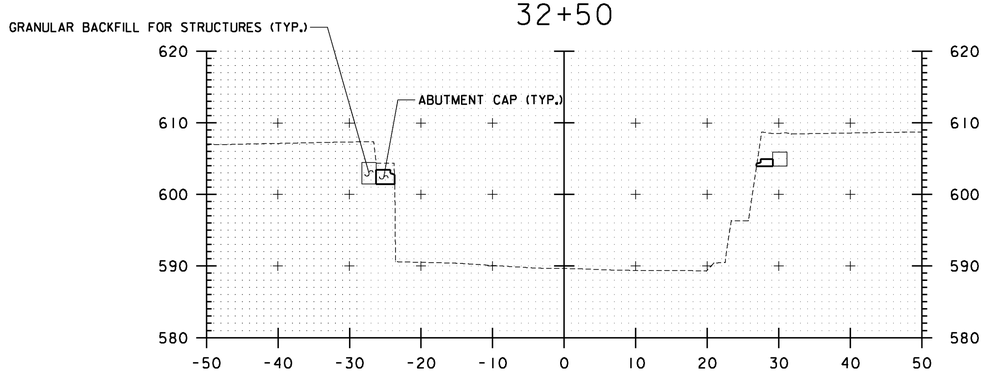

32+25

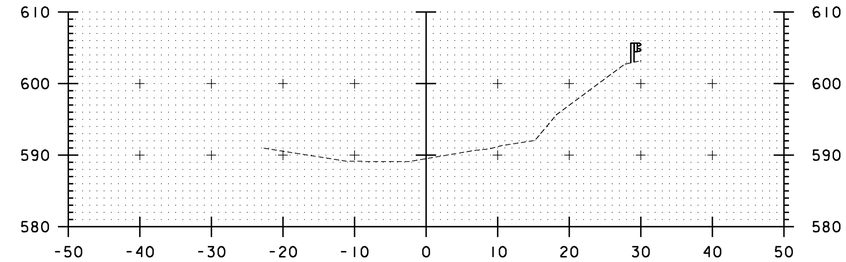

33+50

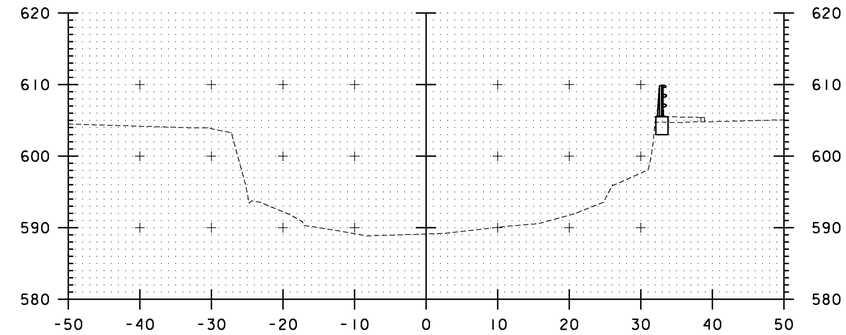

33+25

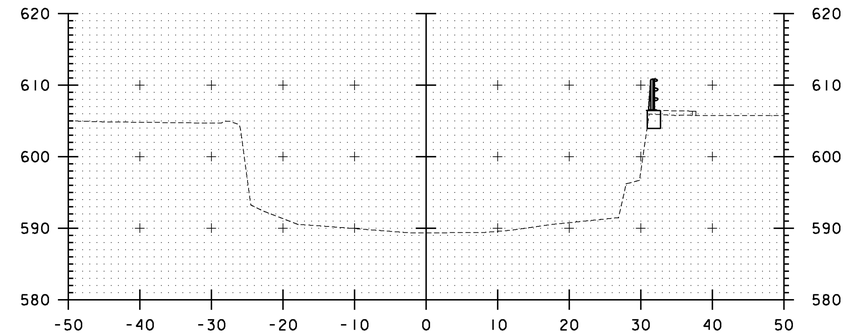

33+00

SCALE 1" = 10'-0
10 0 10

PLOTTED 2/2/2009

DuBois & King inc.
engineering planning management development

STATE OF VERMONT
AGENCY OF TRANSPORTATION

Town Of BARRE CITY	Bridge No. 7
Highway No. PROSPECT ST.	Log Sta. / Surv. Sta.
PROSPECT ST. OVER STEVENS BRANCH	
CHANNEL CROSS SECTIONS	
Designed By A. P. GUYETTE	Drawn By S. J. BIJOLLE
Checked By E. P. DETRICK Date 1/09	Bridge Design Supervisor J. W. TUCKER Date 1/09
PROJECT BARRE CITY	PROJECT NO. BHF 6000 (15) S
I.G.C. Info.	
Bridge Sheet No.	Sheet 56 of 56

I:\R16410\DGN\z95j302xs2.dgn 2/2/2009 10:06:22 AM