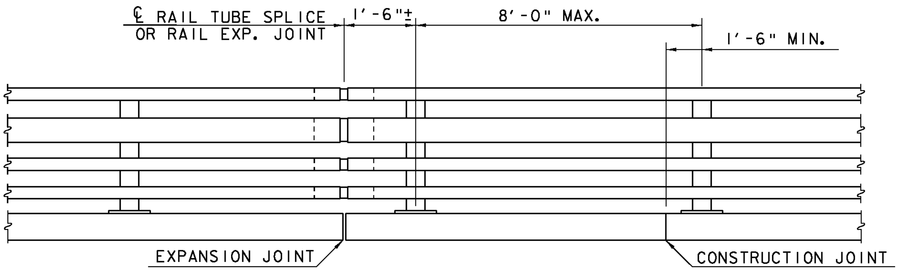

BRIDGE RAILING ELEVATION

(NOT TO SCALE)

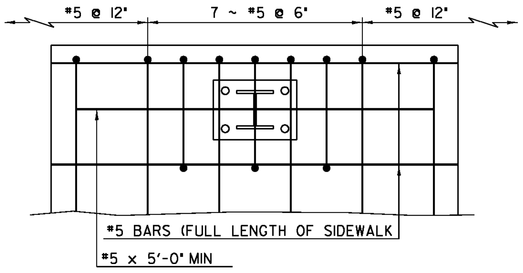

SIDEWALK REINFORCING PLAN

(NOT TO SCALE)

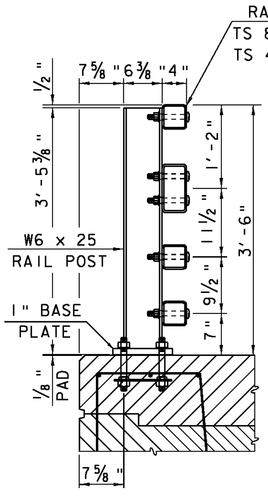

TYPICAL SECTION

(NOT TO SCALE)

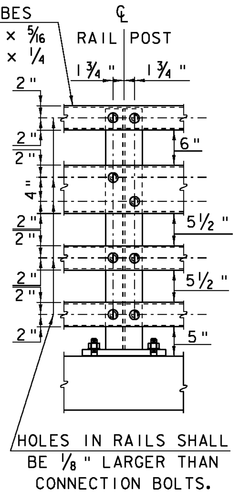

ELEVATION

(NOT TO SCALE)