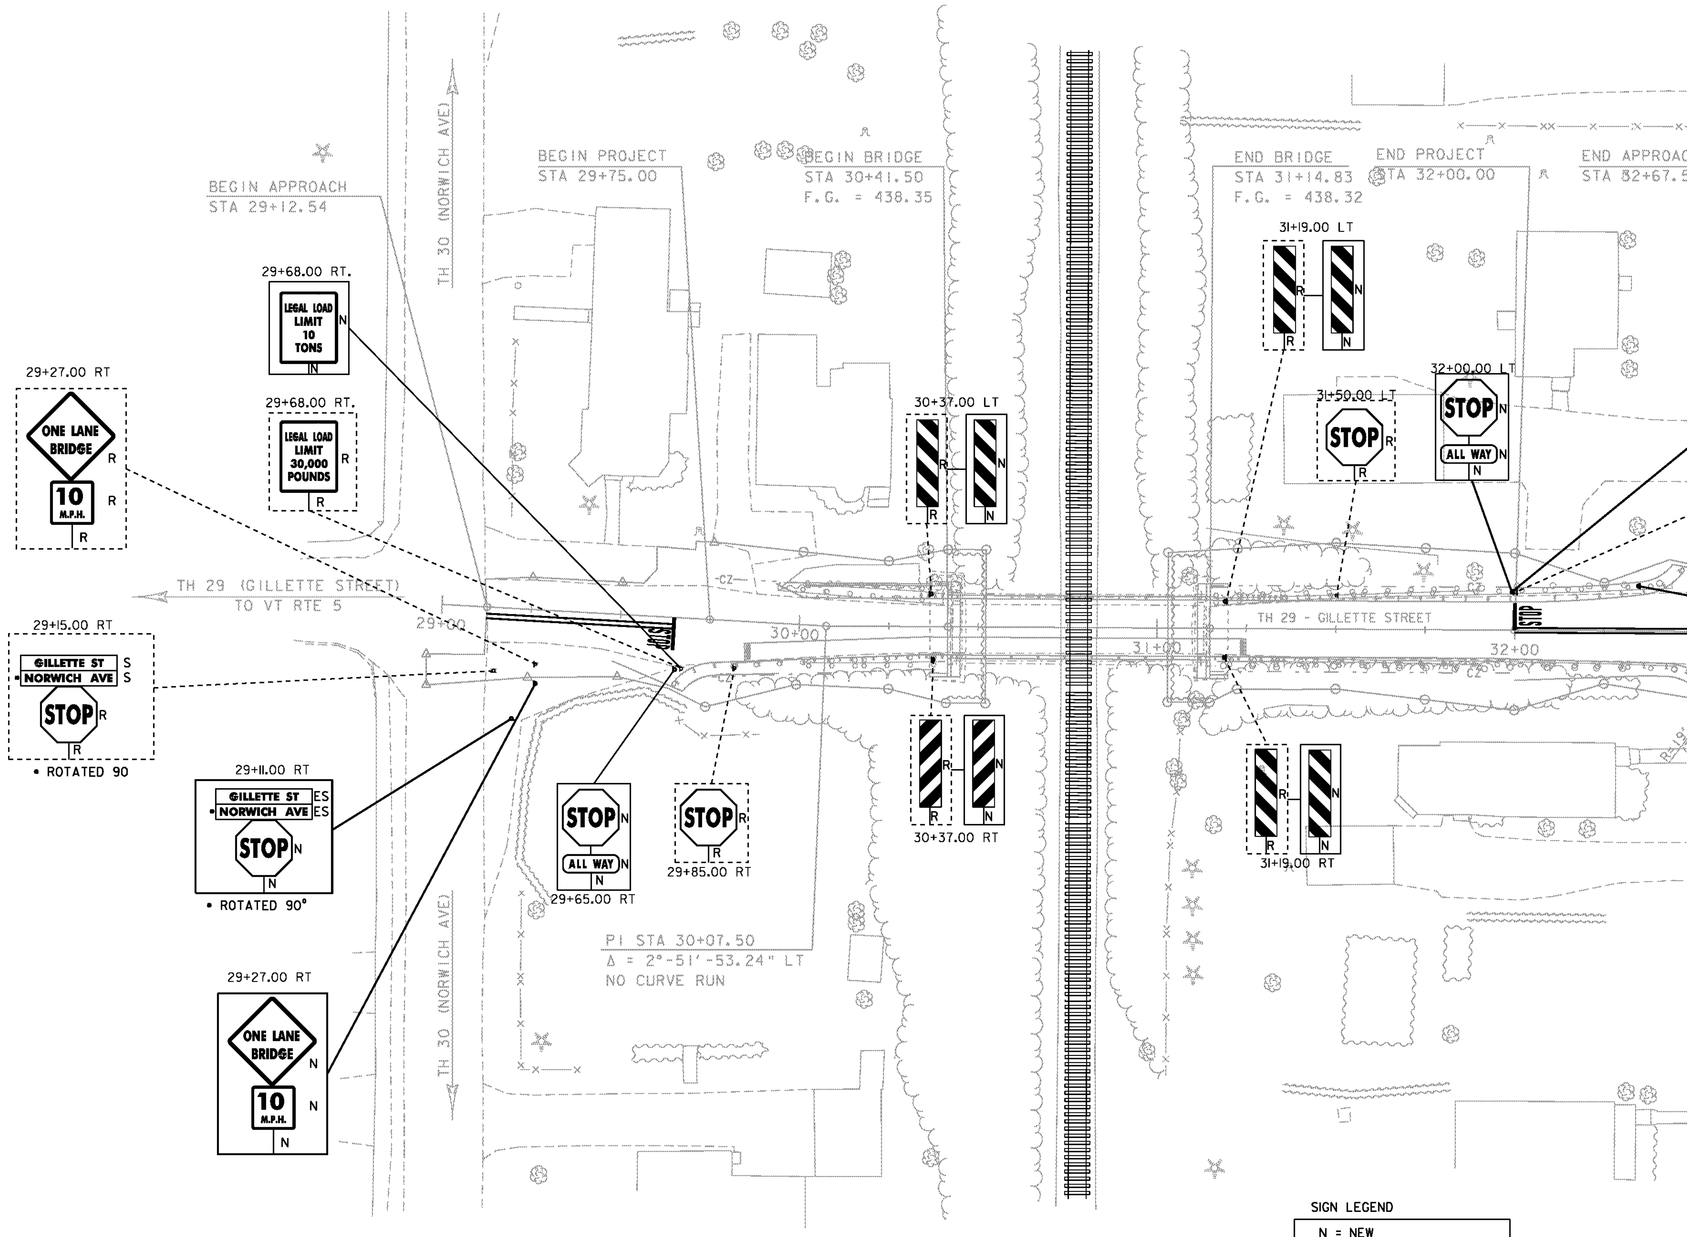

SIGN LEGEND
N = NEW
R = REMOVE
S = SALVAGE
ES = ERECT SALVAGED SIGN

SIGN & PAVEMENT MARKINGS SHEET

SCALE 1" = 20'