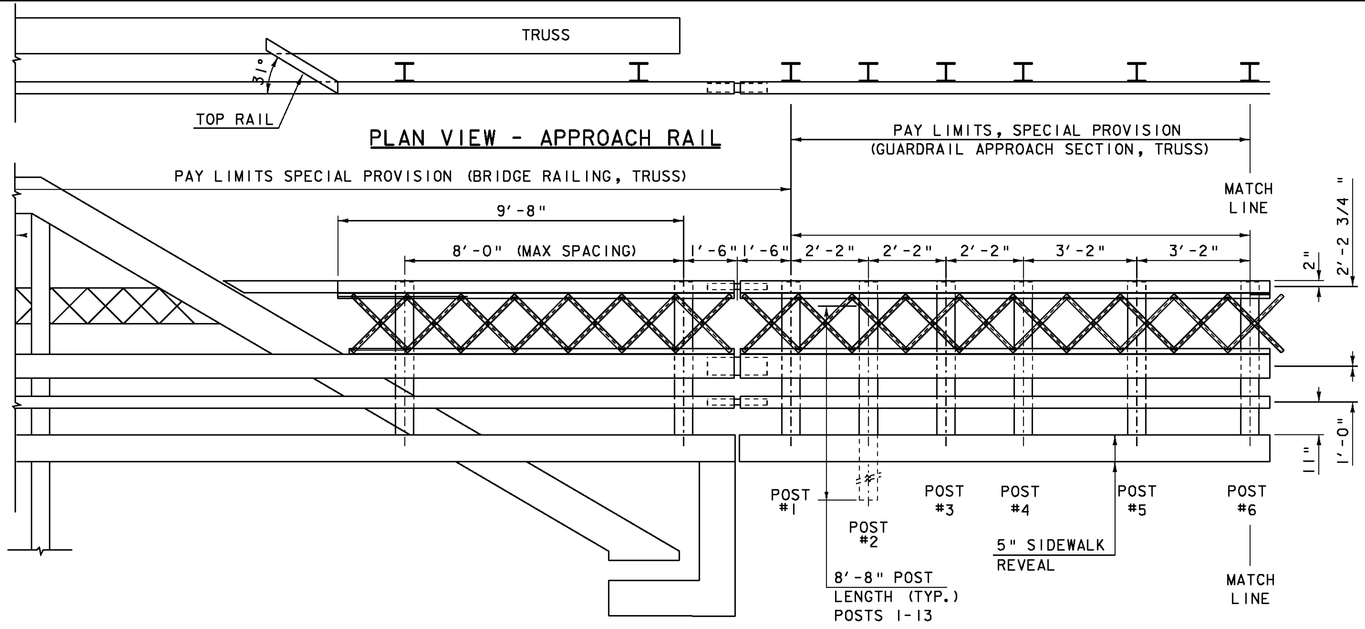

PLAN VIEW - APPROACH RAIL

ELEVATION VIEW - APPROACH RAIL

SCALE ½" = 1'-0"

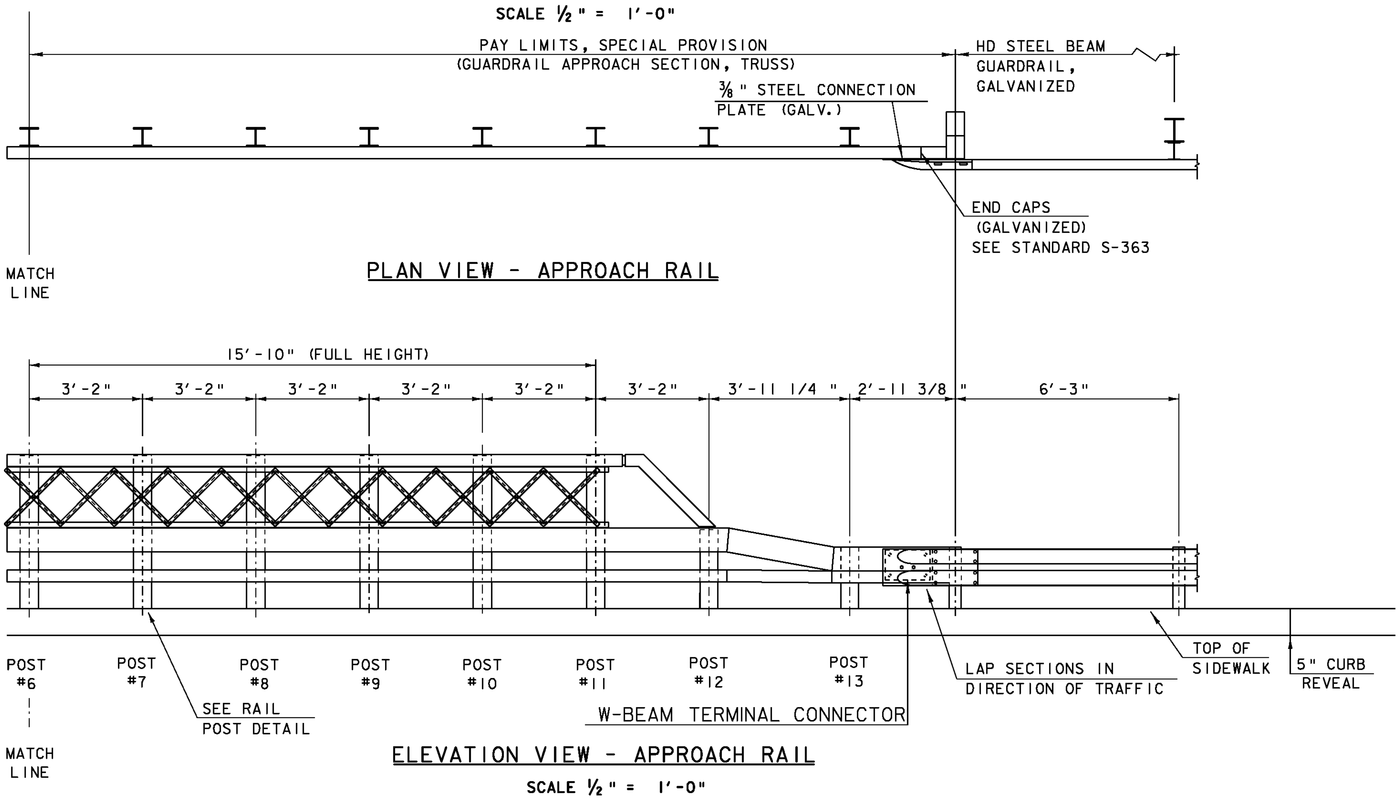

PLAN VIEW - APPROACH RAIL

ELEVATION VIEW - APPROACH RAIL

SCALE ½" = 1'-0"

NOTES

1. REFER TO
   DETAIL -
   MATERIAL
2. PAYMENT F
   TRUSS) SH
   PLATE, RA
3. ALL APPRO
   TRAFFIC F
4. ALL BRIDG
   SHALL BE
   NOTED.
5. APPROACH
   BE AASHTO
   WASHERS S
6. WELD SPLI
   (B-U2).

SCALE ½" = 1'-