N

1.

M

RA
GF

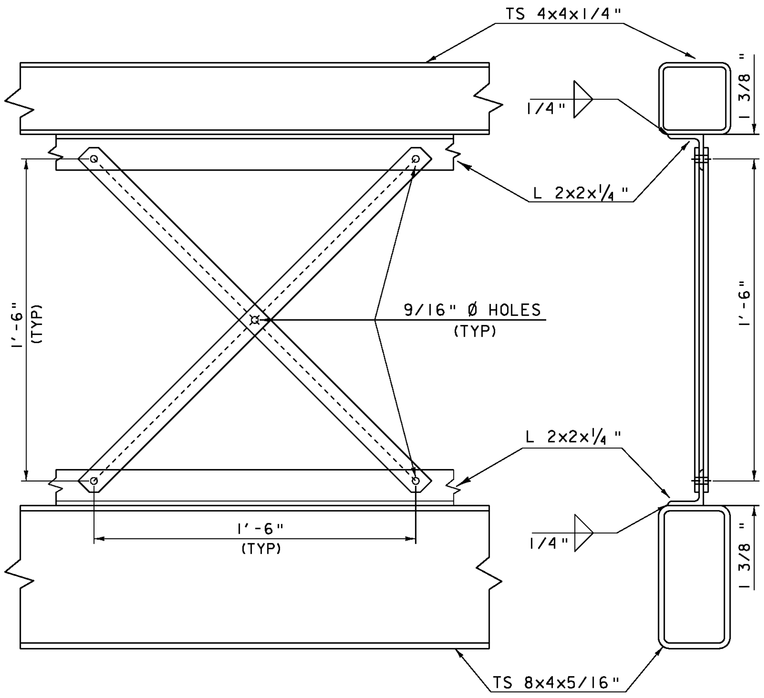

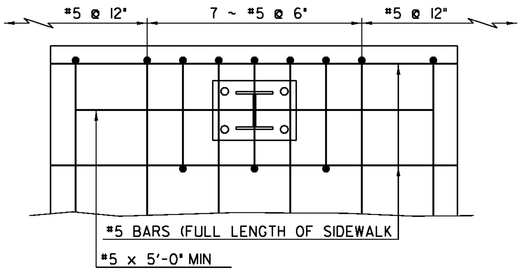

SIDEWALK REINFORCING PLAN

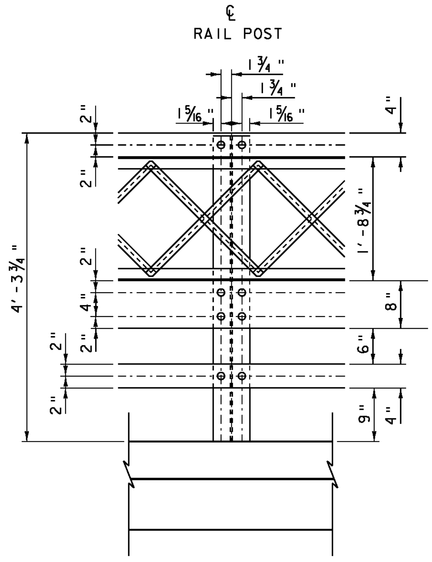

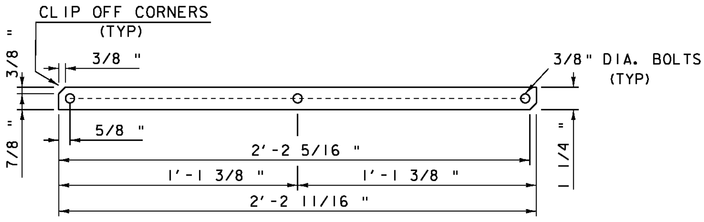

LATTICE BAR

SCALE: 3" = 1'-0"

APPROACH RAILING ELEVATION

SCALE: 1" = 1'-0"

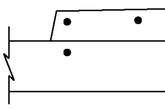

SCALE 1" = 1'-0"

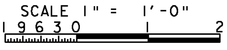
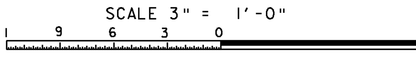
SCALE 3" = 1'-0"