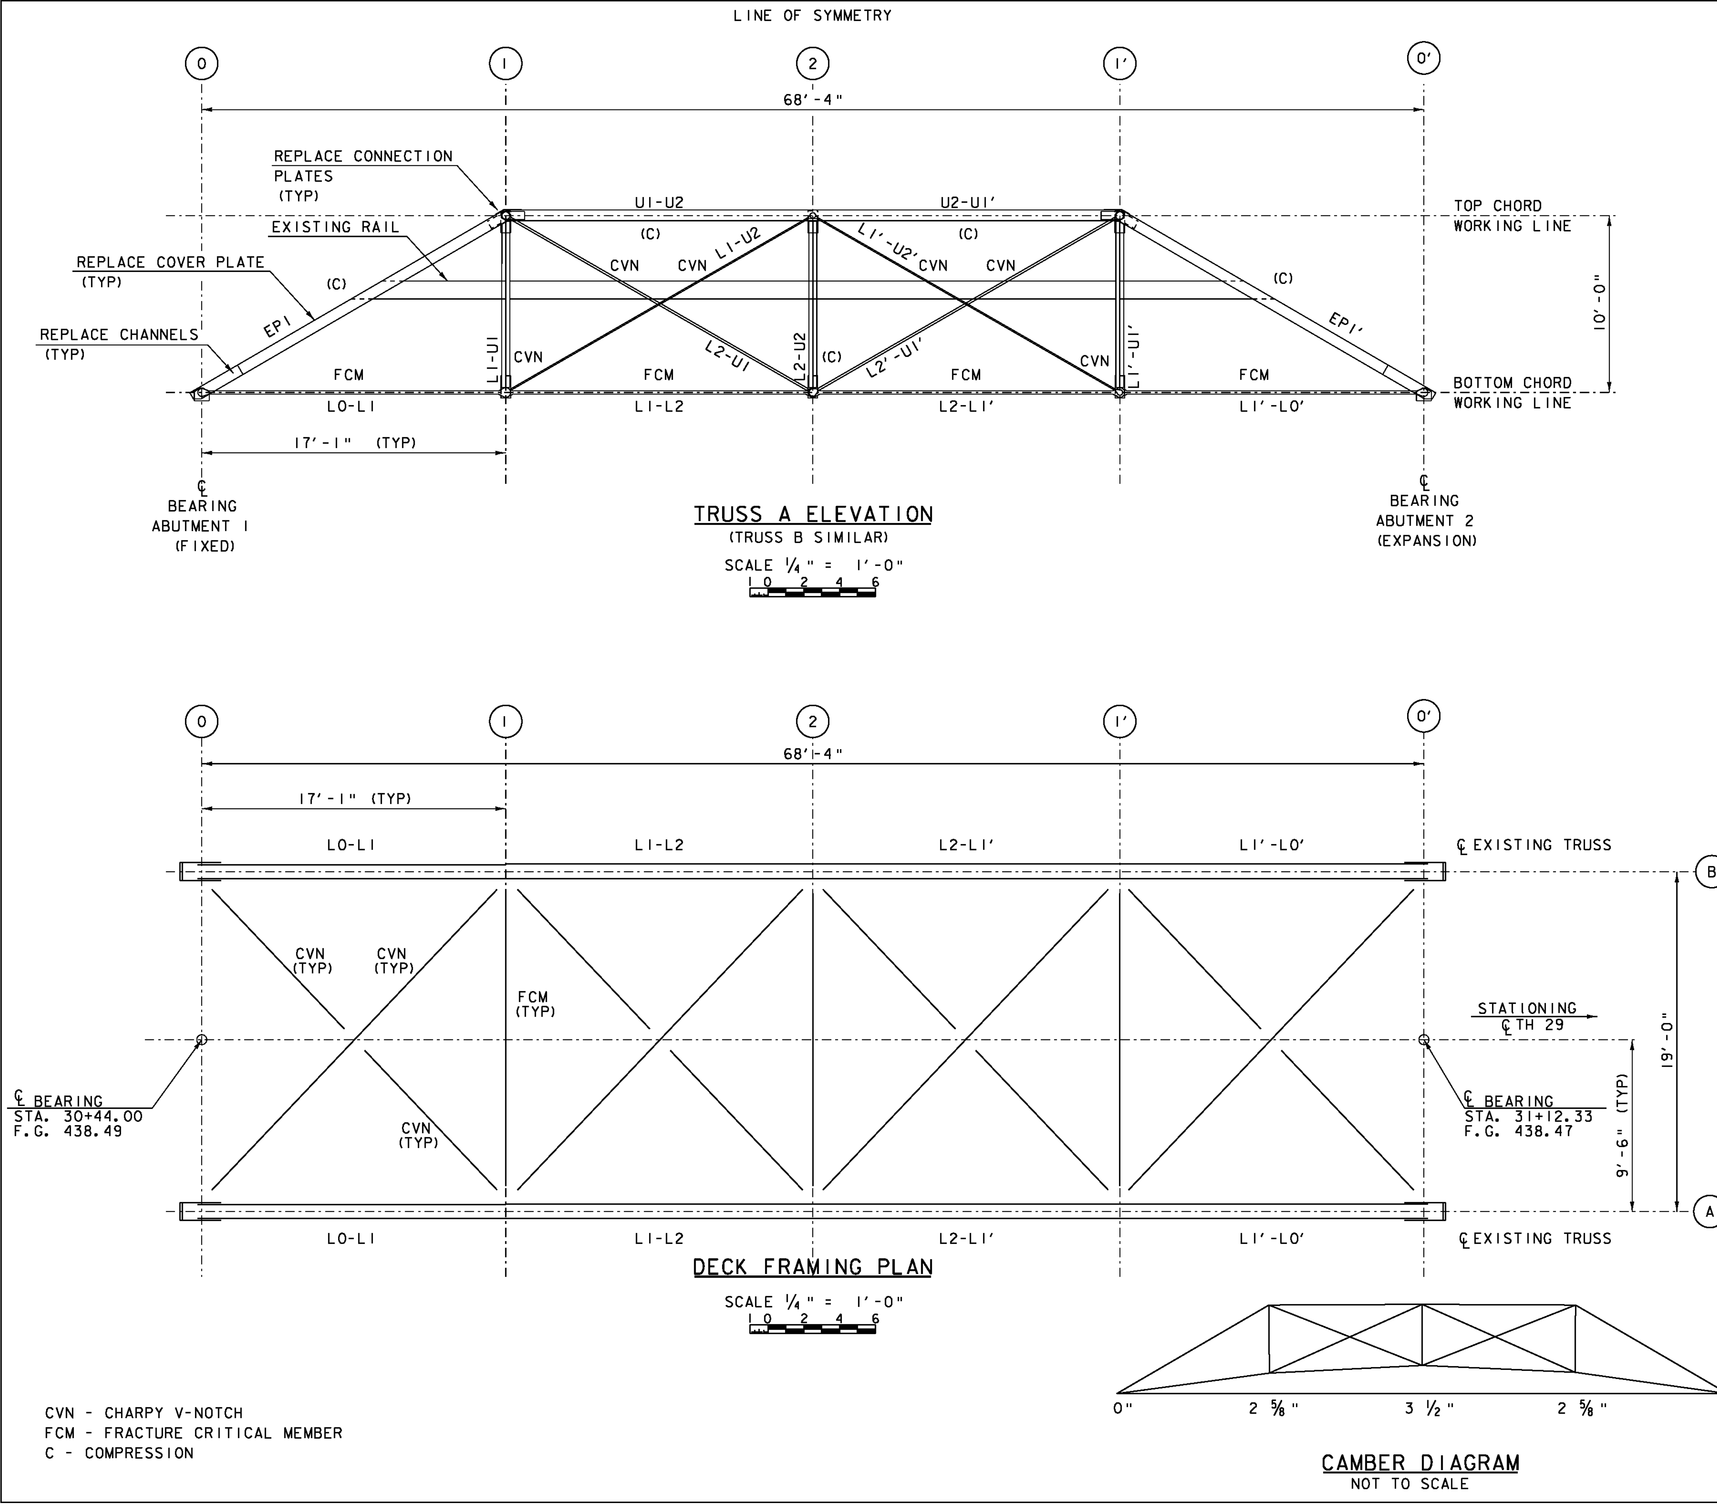

TRUSS A ELEVATION

(TRUSS B SIMILAR)

SCALE 1/4" = 1'-0"

DECK FRAMING PLAN

SCALE 1/4" = 1'-0"

CAMBER DIAGRAM

NOT TO SCALE

CVN - CHARPY V-NOTCH
FCM - FRACTURE CRITICAL MEMBER
C - COMPRESSION