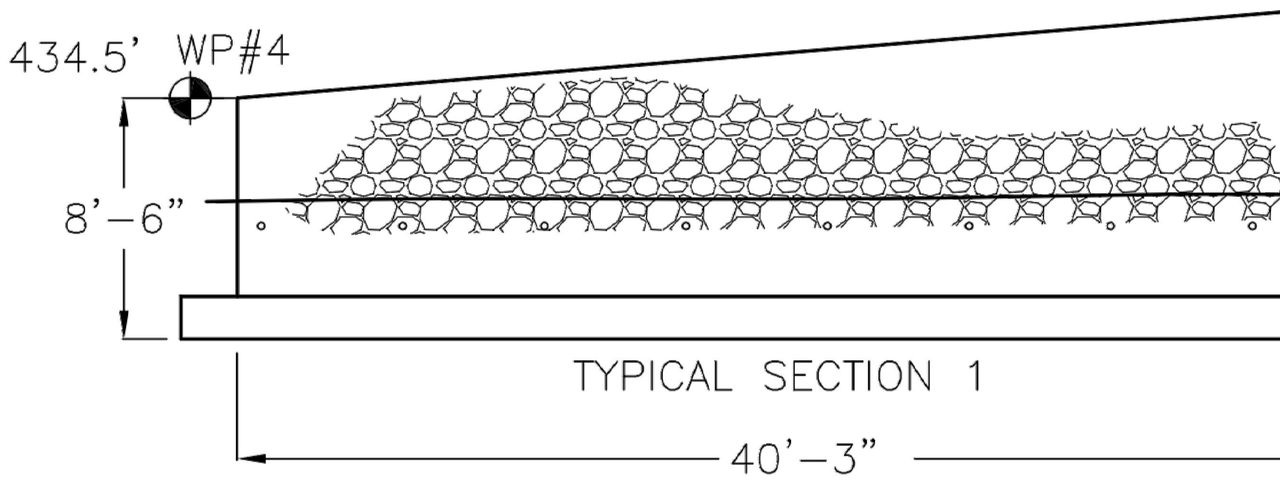

ELEVATION RETAINING WALL WW #1 1"=5'

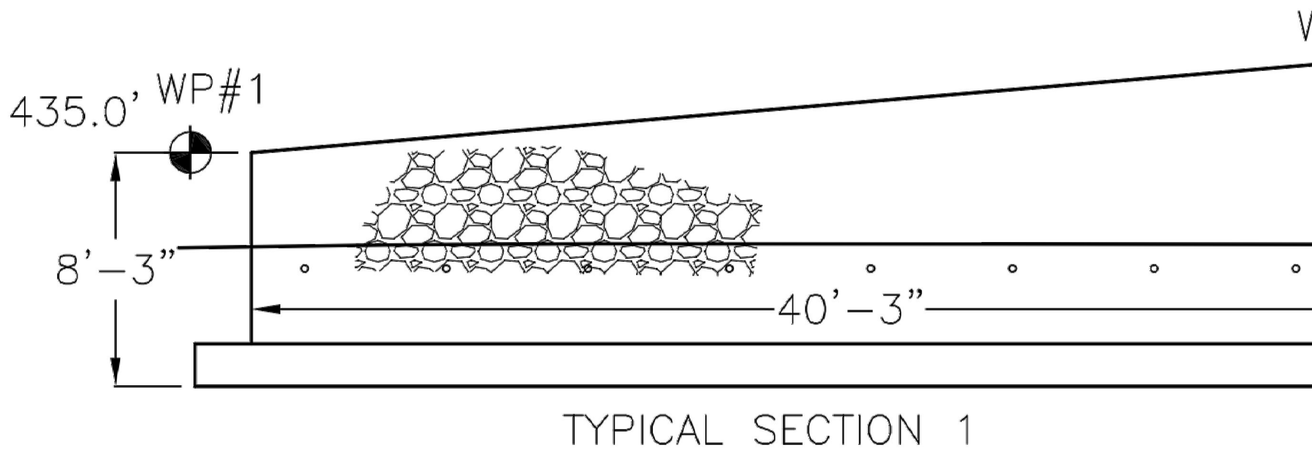

ELEVATION RETAINING WALL WW #2 1"

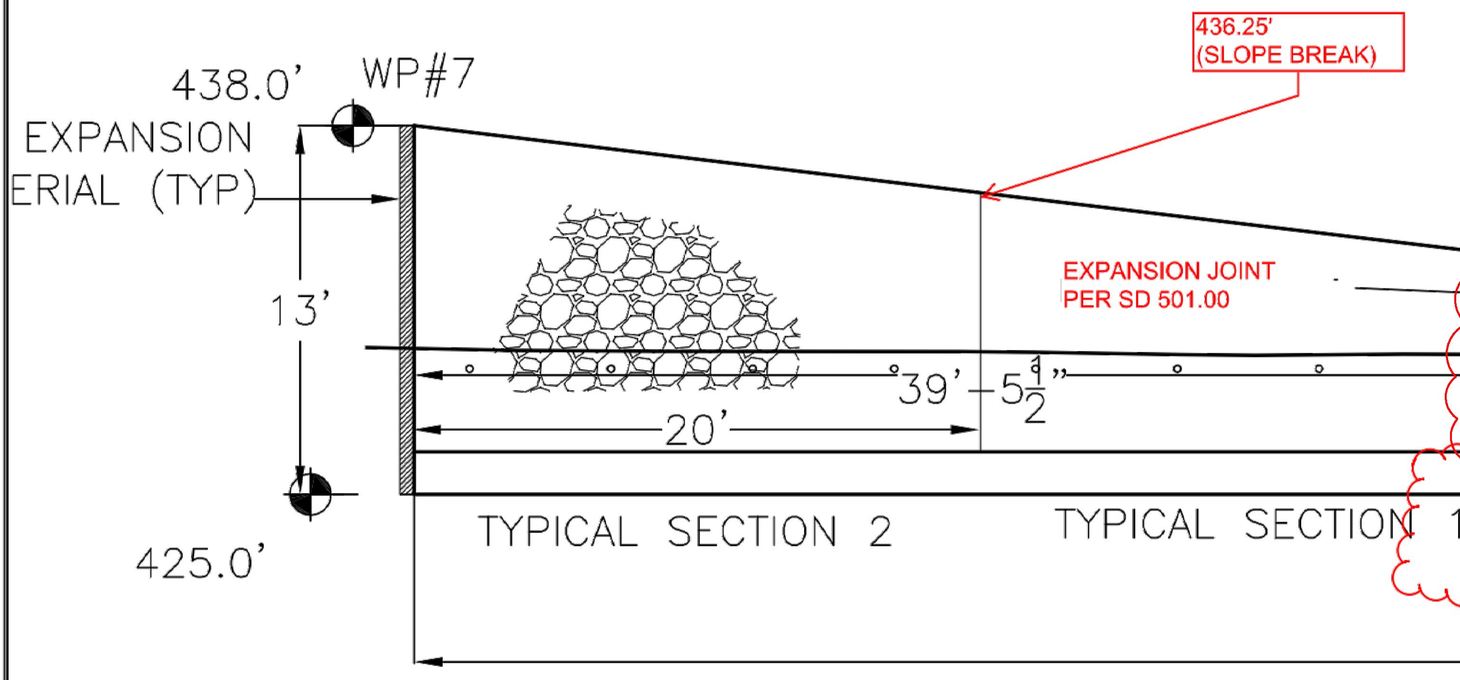
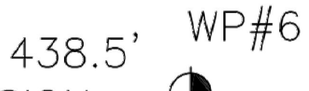
ELEVATION RETAINING WALL W