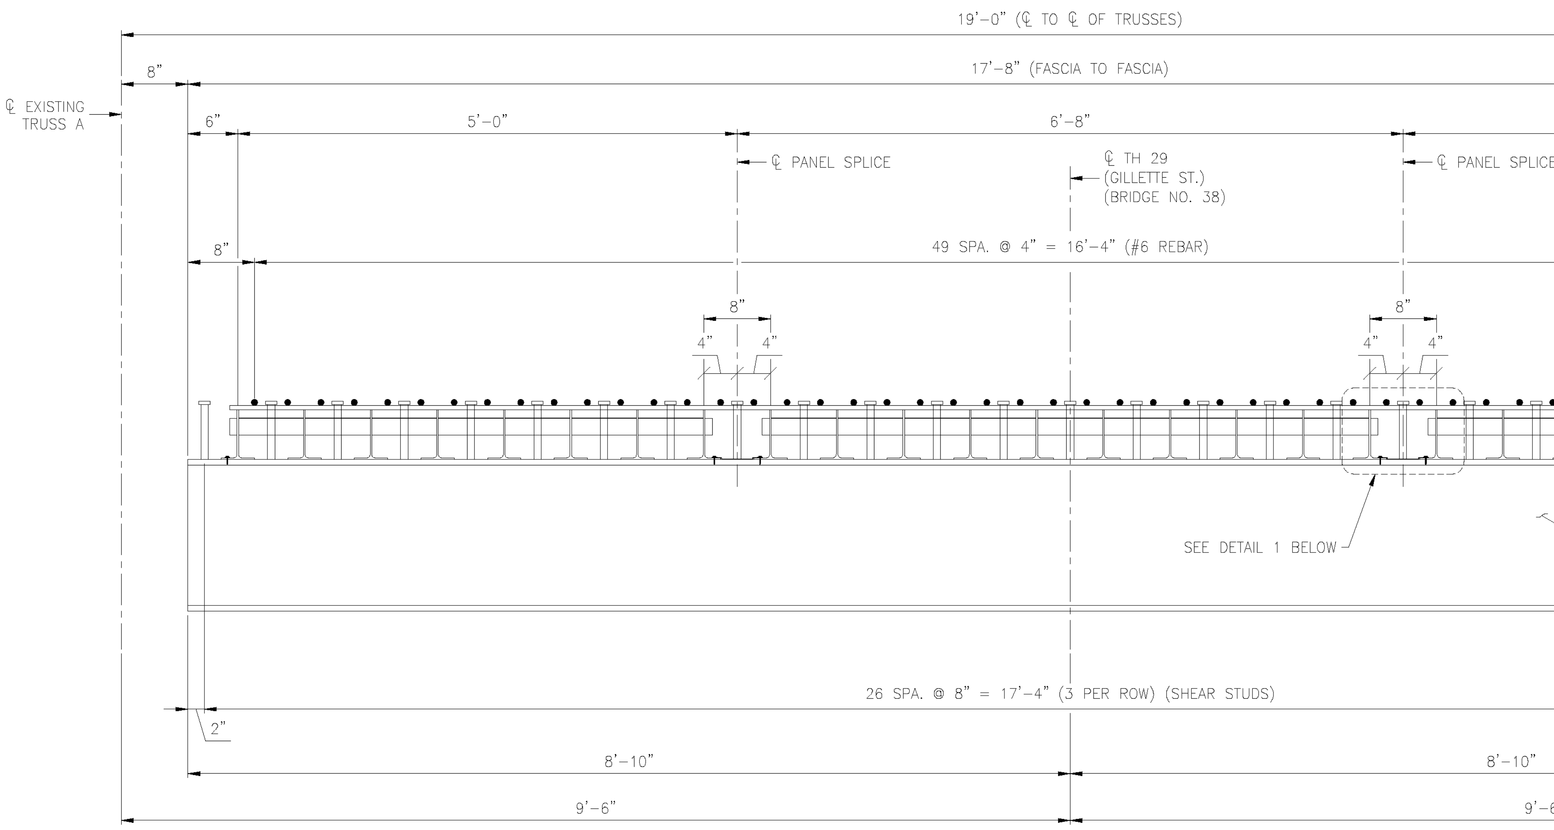

SECTION A-A
BRIDGE CROSS SECTION

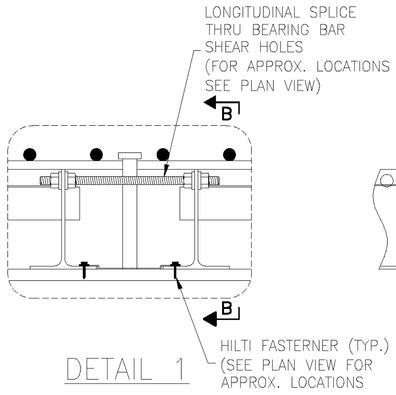

DETAIL 1

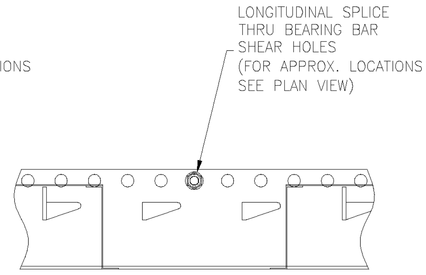

SECTION B-B