COMMON EXCAVATION
STA. 9+25 - 9+67.65
STA. 10+20.07 - 10+50

~~**STONE FILL, TYPE II** ELIMINATED~~
~~BEGIN STA. 9+75 - 19' LEFT AND 18' RIGHT~~
~~END STA. 9+87 19' LEFT AND 18' RIGHT~~
~~BEGIN STA. 10+02 - 20' LEFT AND 18' RIGHT~~
~~END STA. 10+14 - 20' LEFT AND 18' RIGHT~~

SILT FENCE
BEGIN STA. 8+75 LEFT & RIGHT
END STA. 9+75 LEFT & RIGHT
BEGIN STA. 10+05 LEFT & RIGHT
END STA. 11+00 LEFT & RIGHT

FILTER CURTAIN
CHANNEL STA. 0+22E
BEGIN STA. 9+75
END STA. 9+89
BEGIN STA. 10+00
END STA. 10+14
CHANNEL STA. 0+22W
BEGIN STA. 9+75
END STA. 9+89
BEGIN STA. 10+00
END STA. 10+14

PLANK RAIL (MODIFIED)
STA. 9+30 - 9+70 LEFT& RIGHT
STA. 10+18 - 10+53 LEFT
STA. 10+18 - 10+61 RIGHT

REMOVAL AND DISPOSAL OF GUARD RAIL
STA. 9+45 - 9+65 LEFT & RIGHT
STA. 10+20 - 10+40 LEFT
STA. 10+20 - 10+30 RIGHT

COLD PLANING
STA. 8+75 TO 9+00
STA. 10+75 TO 11+00

REMOVING AND RESETTING FENCE
STA. 10+40 - 10+70 RIGHT

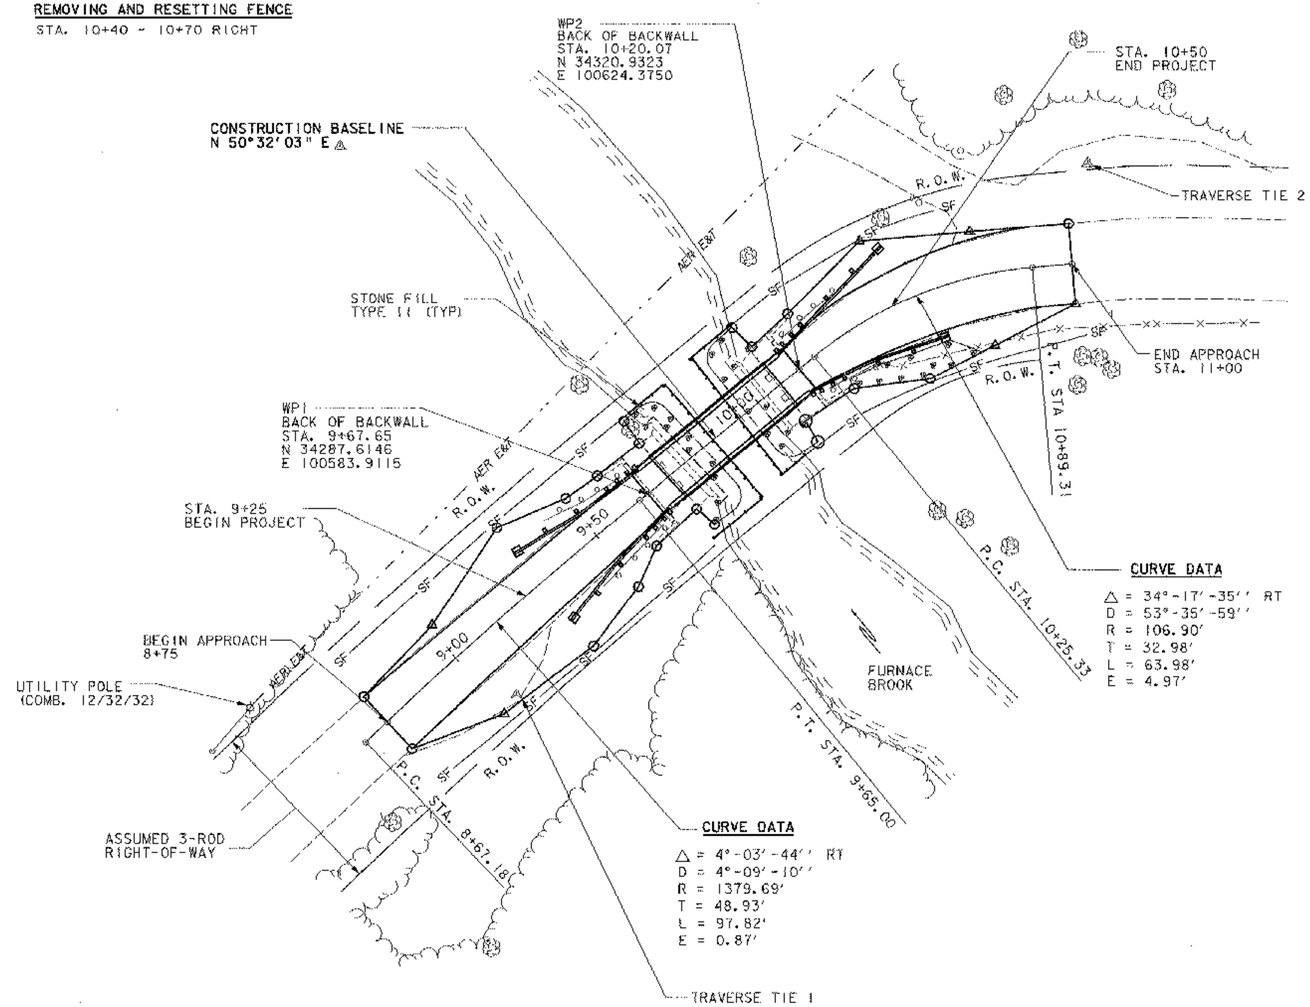

RIGHT-OF-WAY
EXISTING STONE ABUTMENT/WINGWALL
AER E&T OVERHEAD UTILITY LINES
SF SILT FENCE
FILTER CURTAIN

PLAN VIEW

N
VT STATE PLANE GRID

SCALE 1" = 20'-0
20 0 20

DATUM
VERTICAL
HORIZONTAL

Lichtenstein
Consulting Engineers

PROJECT NAME: PITTSFORD	
PROJECT NUMBER: BHO 1443 (36)	
FILE NAME: ...\cooigpl.dgn	PLOT DATE: 03 JAN 2003
PROJECT LEADER:	DRAWN BY: J. MESSIER
DESIGNED BY: J. MESSIER	CHECKED BY: E.ALLEN RANDALL
	SHEET 3 OF 15

03 JAN 2003 p:\2074\copley bridge\cadd\dgn\cooigpl.dgn