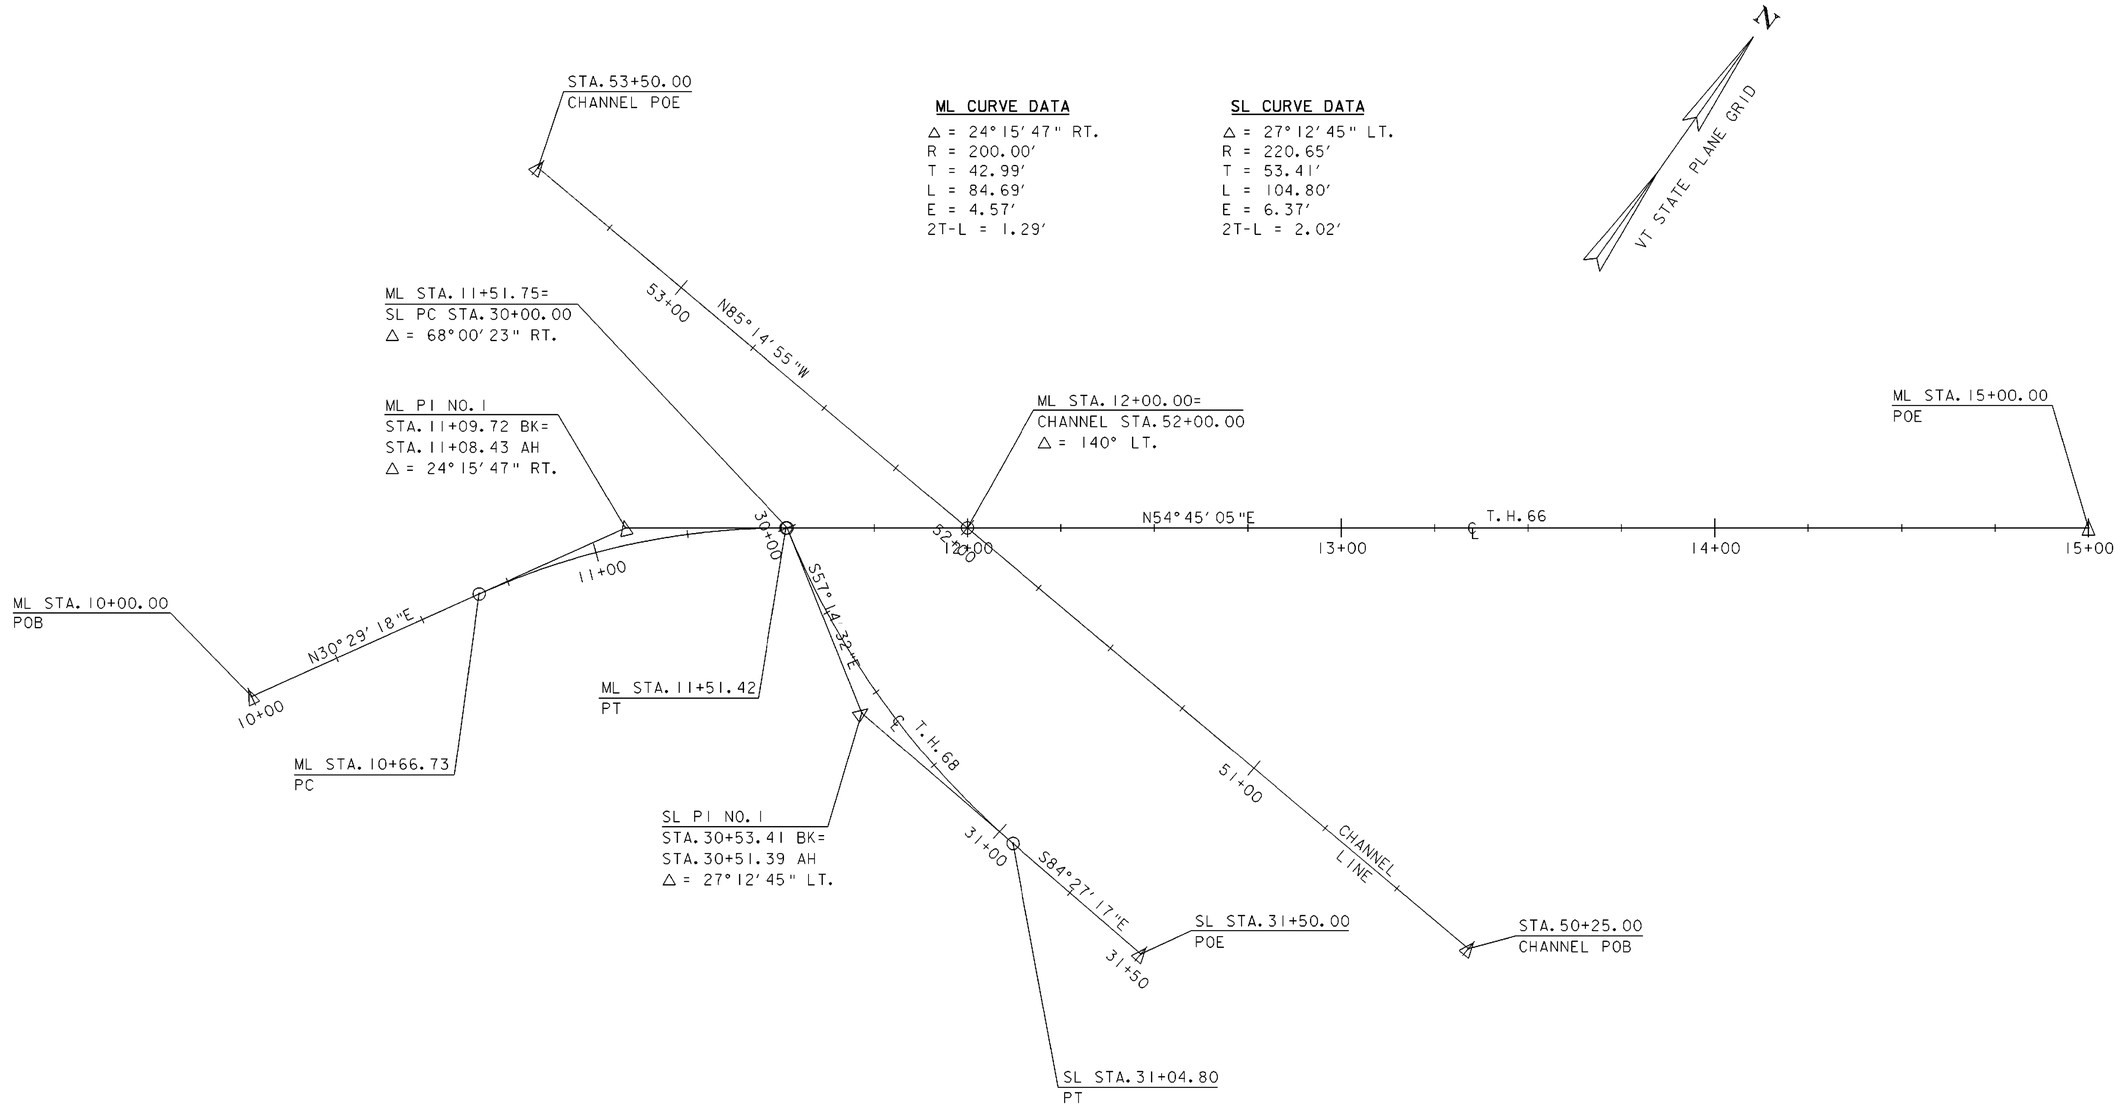

ALIGNMENT SHEET

20 0 20

SCALE: 1" = 20'-0"

PROJECT NAME:	SPRINGFIELD
PROJECT NUMBER:	BHO 1442(30)

FILE NAME: 96J348\structures\s96J348ali.1	PLOT DATE: 27-DEC-2007
PROJECT MANAGER: R. R. WHITCOMB	DRAWN BY: G. ROY
DESIGNED BY: G. ROY	CHECKED BY: C. CARLSON
s96J348ali.1	SHEET 8 OF 85