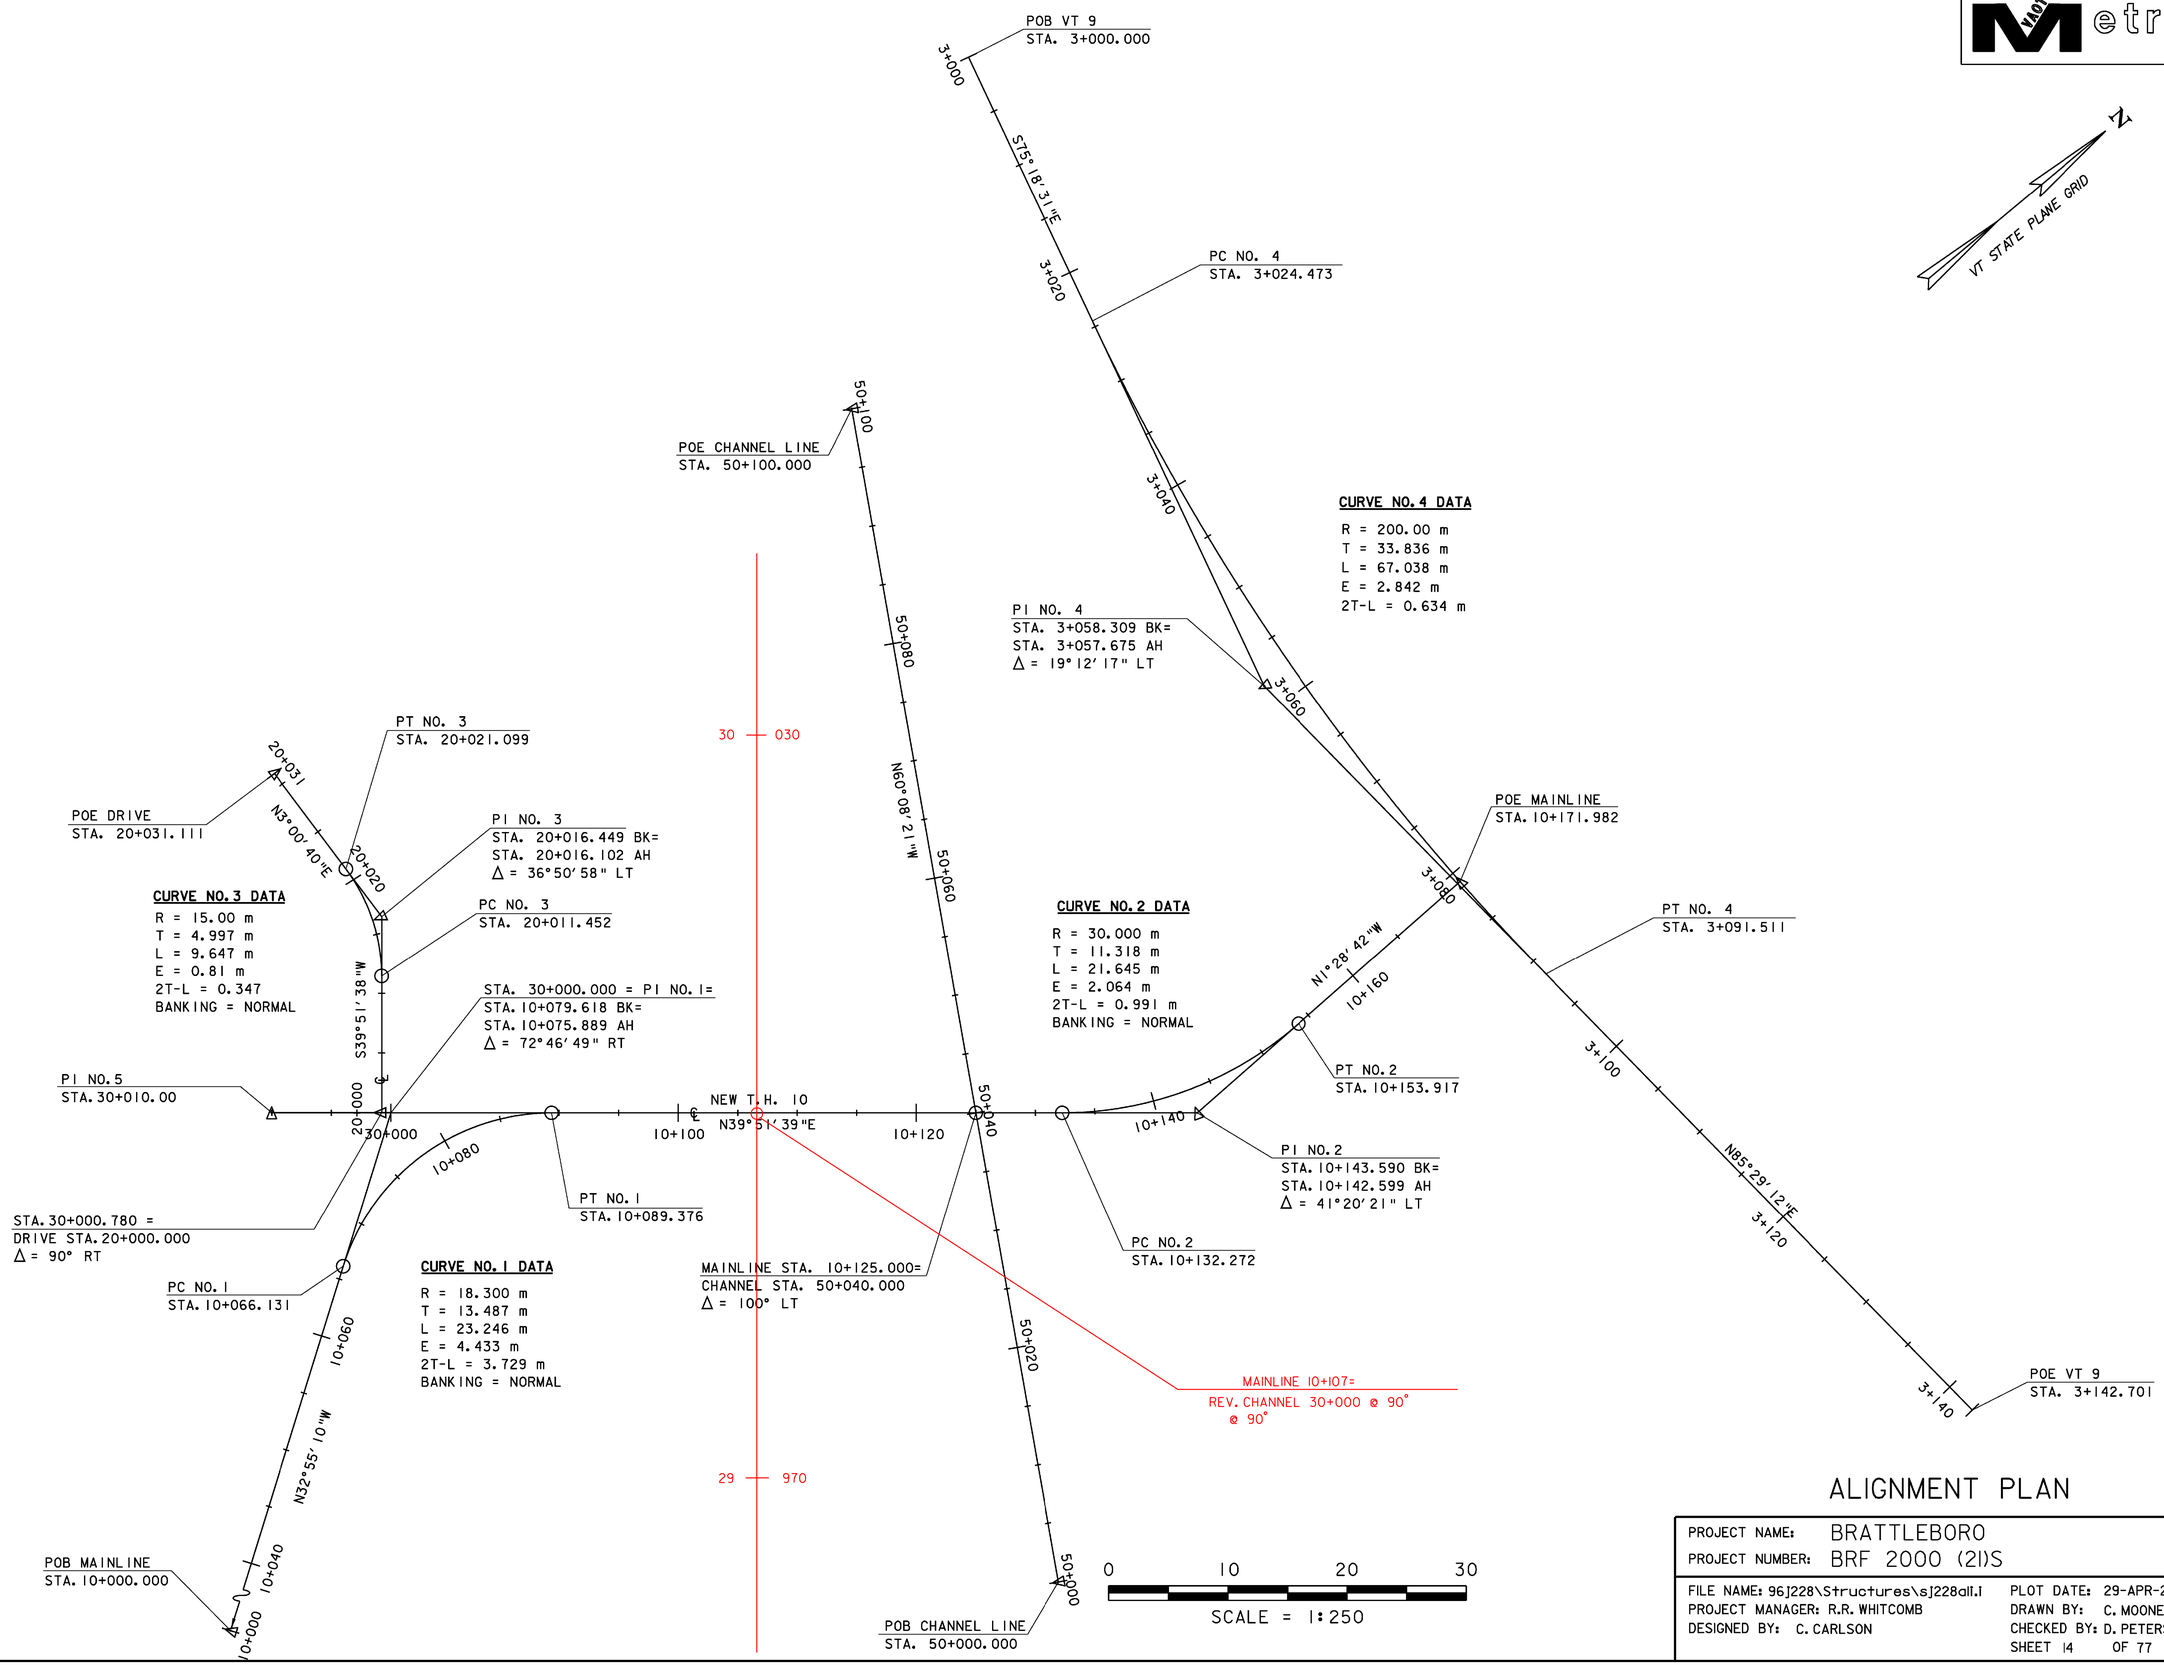

ALIGNMENT PLAN

PROJECT NAME:	BRATTLEBORO
PROJECT NUMBER:	BRF 2000 (21)S

FILE NAME: 96J228\Structures\sJ228all.1	PLOT DATE: 29-APR-2009
PROJECT MANAGER: R.R. WHITCOMB	DRAWN BY: C. MOONEY
DESIGNED BY: C. CARLSON	CHECKED BY: D. PETERSON
	SHEET 14 OF 77