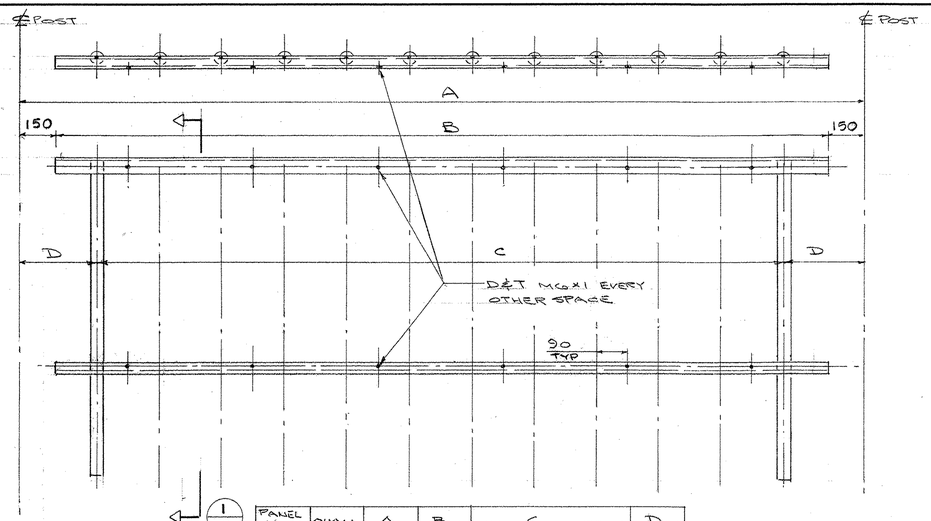

1 / F2

PANEL No.	QUAN	A	B	C	D
A1	18	2435	2135	11 SP. AT 176 = 1936	250

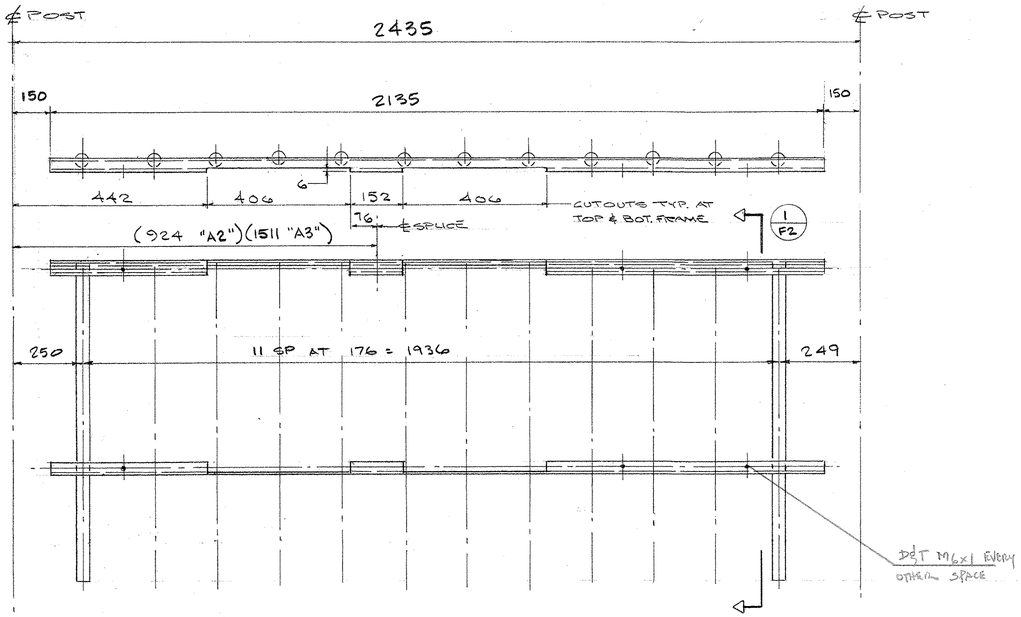

SPINDLE PANEL "A2" (2 REQ'D.) "AS SHOWN"
"A3" (2 REQ'D.) "OPPOSITE HAND"

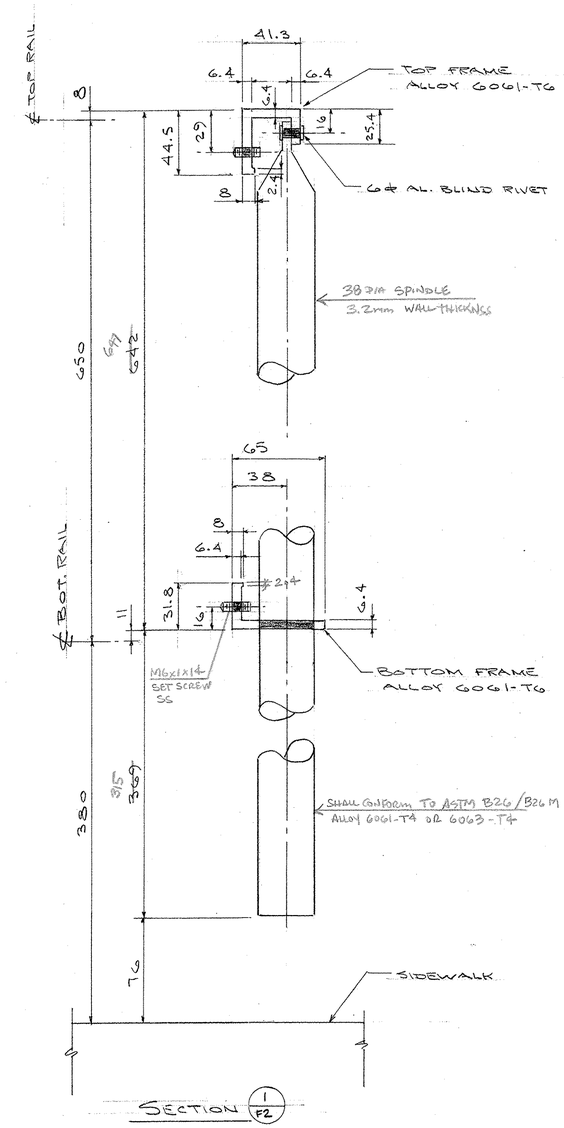

SECTION 1 / F2

RECEIVED
CK'D BY DRP COPY GRS
APR 06 2010
RESUBMIT_____ APPROVED AS NOTED
BY CNC DATE 4/20/10

DIM'S ARE GIVEN IN MILIMETERS

AUCIELLO IRON WORKS INC
560 MAIN ST. HUDSON, MA (978) 568-8382

VT. AGENCY OF TRANSPORTATION
BRATTLEBORO #BRF 2000(21)S
BRIDGE # 30
T.H. 10 OVER WHETSTONE BROOK

AL: BRIDGE & APPROACH RAILING

SURFACE PREP: NONE	FINISH: BLACK ANODIZE
FOR: F.R. LAFAYETTE, INC	
DR: DRP 2-3-2010 CHK: 4/5/10	DWG. NO. BR-2978
JOB NO. AB07025-1001	SHEET F2 OF 5

ISSUE	DATE	DESCRIPTION	BY
1	4/5/10	FOR APPROVAL	

