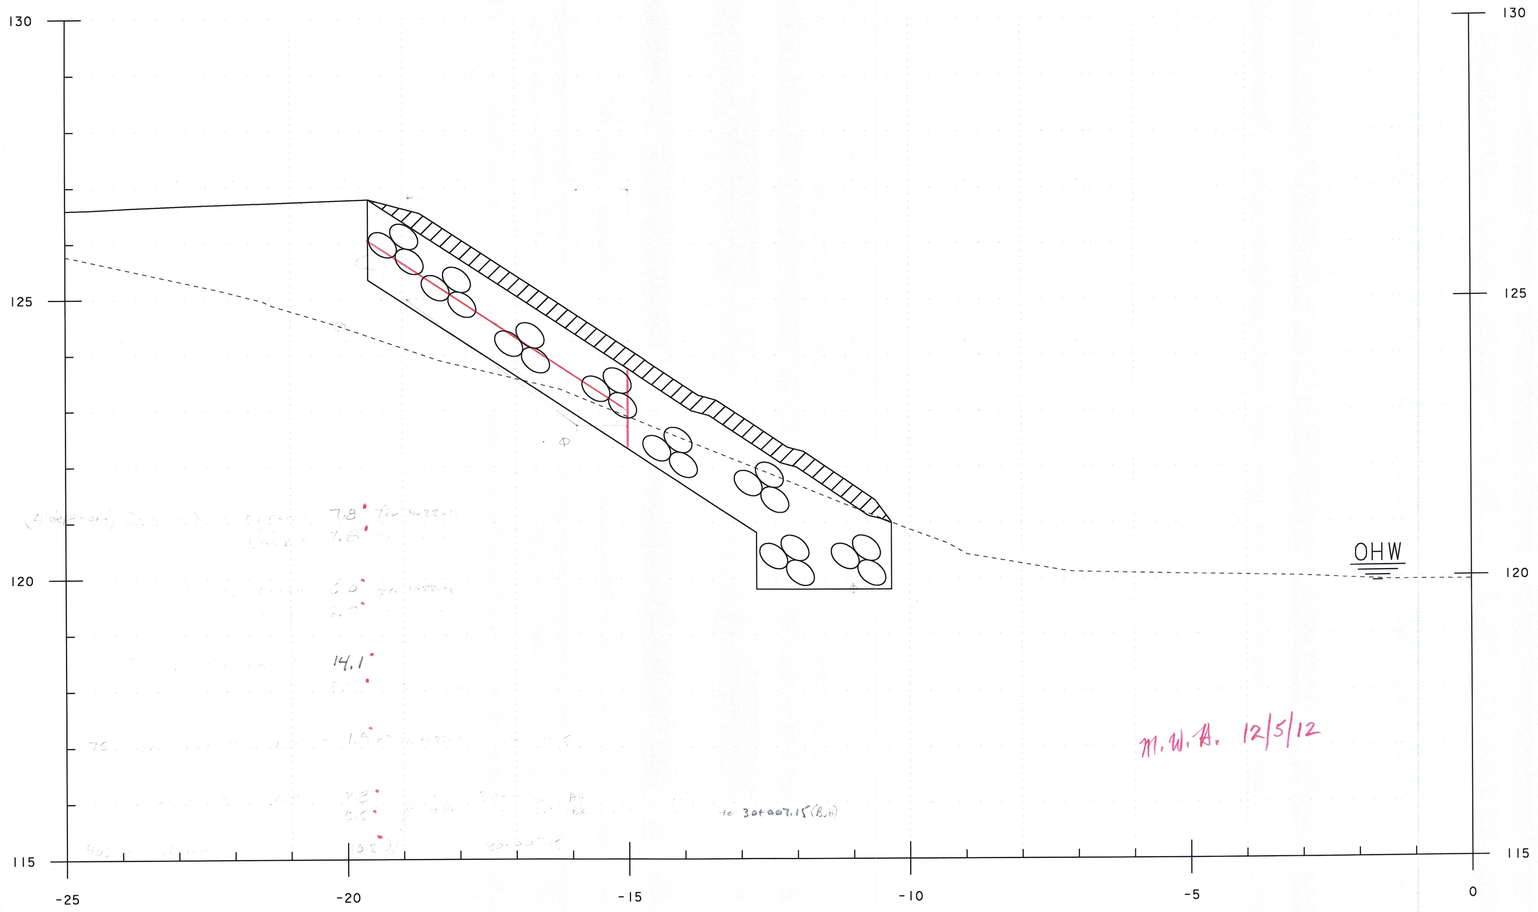

30+006.55

STA. 30+007 TO STA. 30+007

PROJECT NAME: BRATTLEBORO	
PROJECT NUMBER: BRF 2000(21)S	
FILE NAME: 96J228/str/sJ228xsl.dgn	PLOT DATE: 13-AUG-2009
PROJECT LEADER: R. WHITCOMB	DRAWN BY: C. MOONEY
DESIGNED BY: C. CARLSON	CHECKED BY: D. PETERSON
------ ------	SHEET 0~~15~~20 OF 27