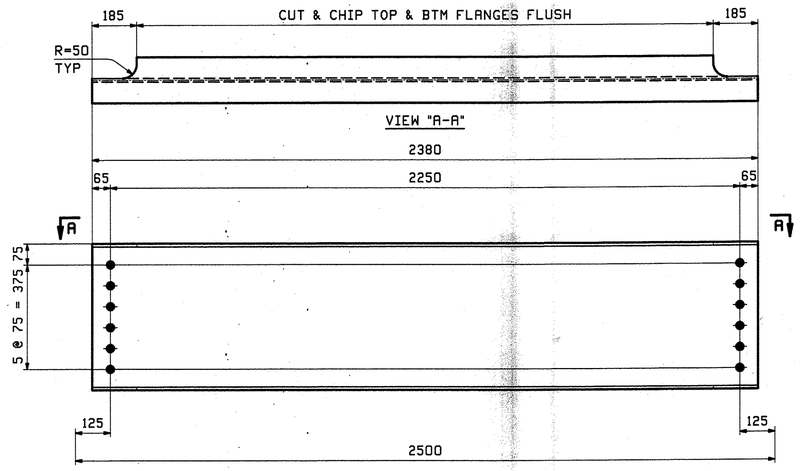

20~ INT. DIAPHRAGMS - 6D1

ABM INFO		SHIP	BILL OF MATERIAL					JOB NO.	DRAWING NO.	REV.
								418	6	
PAGE	LINE	MARK	QTY	MARK	MATERIAL	LENGTH m	LENGTH mm	REMARKS	WT	PROCUREMENT NOTES
					INT DIAPHRAGMS					
2	G	6D1	20		W 530x65.5	2	380		156 kg 343 lbs	

REV.	DATE	REMARKS	DWN	CHK	APVL	SHOP
0					JUL 22 2009	

MATERIAL:	SURFACE PREP. & PAINT:	HOLES:	SHOP BOLTS:
M270M-345W	SEE DWG GN1	$\frac{15}{16}$" ø	NONE

DESCRIPTION: DIAPHRAGMS

CASCO BAY STEEL STRUCTURES, INC.
75 SPRING HILL ROAD SACO, MAINE 04072
PHONE (207) 282-7360 FAX. (207) 282-1179
TENSOR 2894

STRUCTURE: T.H. 10 over Whetstone Brook BRIDGE NO 30 Brattleboro Windham County	DRAWN: JTB	DATE: 07/16
	CHKD: PCP	DATE: 07/21
LOCATION: Town of Brattleboro, VERMONT	JOB NO.	DWG NO.
PROJ NO. BRF 2000(21)S	418	6
CUSTOMER: VT AOT		REV. △

RECEIVED
CK'D BY ____ CK'D BY DRP
JUL 29 2009
RESUBMIT ____ APPROVED ____
BY ____ DATE 8-11-09
VTrans - PDD
JUL 29 2009
Structures Design Section

PCP Tue, Jul 21, 2009 10:08:05 PM c:\temp\jobs\2894\6.1.dwg