INDEX OF SHEETS

1. TITLE SHEET
2. QUANTITY SHEET
3. GENERAL NOTES SHEET
4. LAYOUT SHEET
5. PROFILE SHEET
6. FRAMING PLAN
7. BEAM ELEVATION
8. MISCELLANEOUS DETAILS

STATE OF VERMONT
AGENCY OF TRANSPORTATION

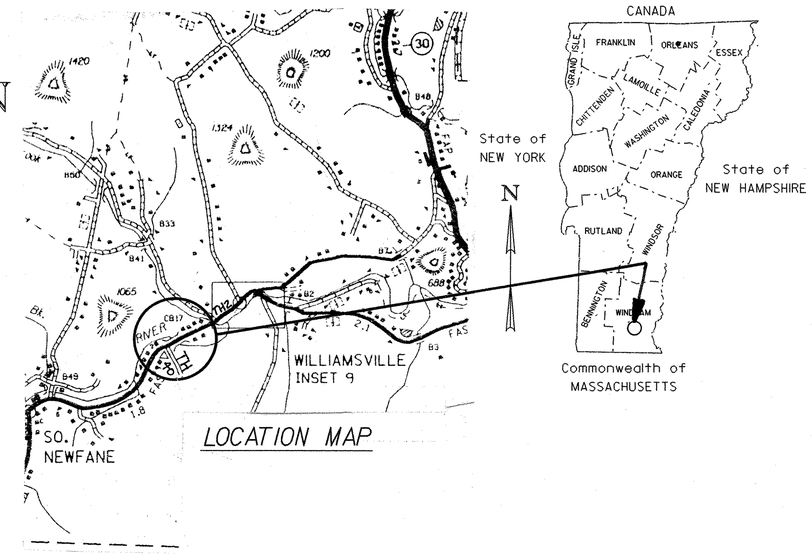

PROPOSED IMPROVEMENT BRIDGE PROJECT

TOWN OF NEWFANE

COUNTY OF WINDHAM

ROUTE NO : TH2, CLASS 2 BRIDGE NO : CB17

PROJECT LOCATION : ON TH 2 EAST OF THE INTERSECTION WITH TH. 40

PROJECT DESCRIPTION : REPAIRS TO COVERED BRIDGE SUPERSTRUCTURE AND MINOR APPROACH WORK.

LENGTH OF STRUCTURE : 120′ ± FEET.

STANDARD SHEETS

E-100	1-6-97
E-101	3-10-97
E-107	8-8-95
E-120	8-8-95
E-121	8-8-95
E-160	8-18-95

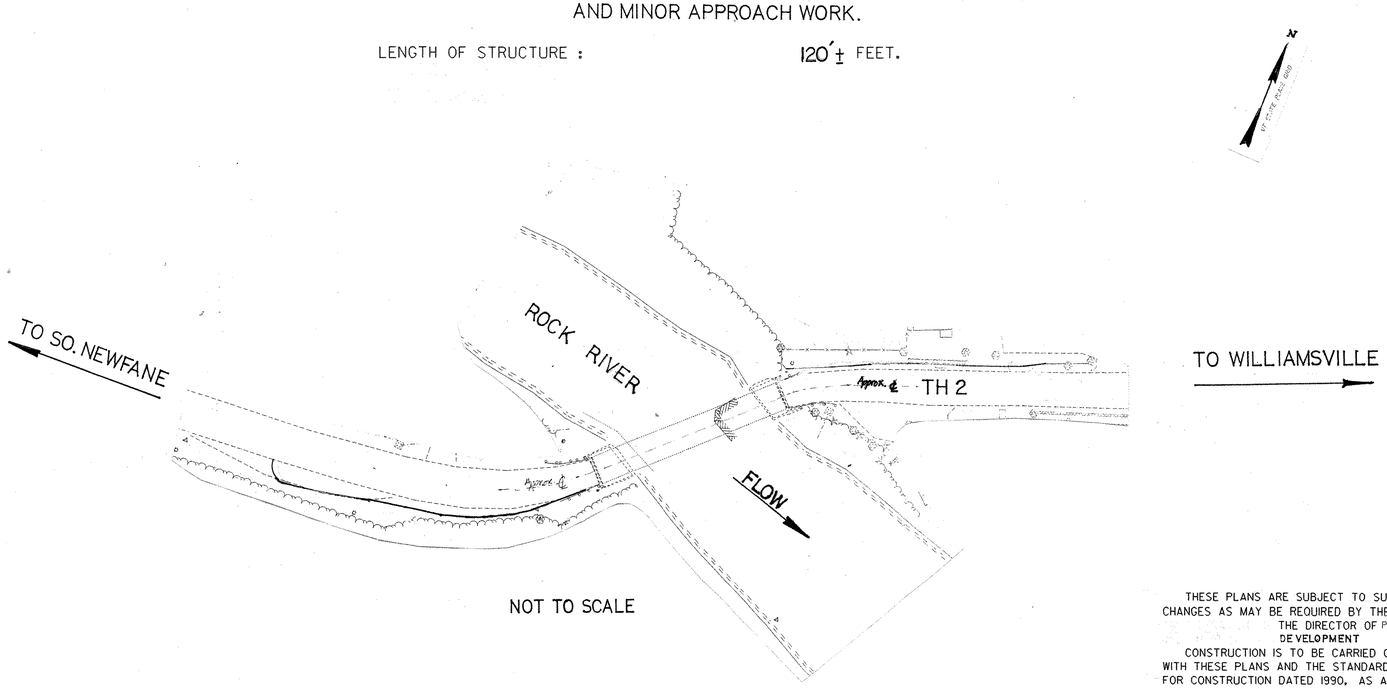

CONVENTIONAL SIGNS

COUNTY LINE
TOWN LINE
LIMITS OF ACCESS
POINT OF ACCESS
FENCE LINE
STONE WALL
TRAVELED WAY
GUARD RAIL
RAILROAD
SURVEY LINE
CULVERT
POWER POLE
TELEPHONE POLE
TREES
CONTROL OF ACCESS
PROPERTY LINE
R.O.W. TAKING LINE
SLOPE RIGHTS
TOP OF CUT
TOE OF SLOPE

DATUM
VERTICAL _____
HORIZONTAL _____

THESE PLANS ARE SUBJECT TO SUCH ENGINEERING CHANGES AS MAY BE REQUIRED BY THE THE DIRECTOR OF PROJECT DEVELOPMENT

CONSTRUCTION IS TO BE CARRIED ON IN ACCORDANCE WITH THESE PLANS AND THE STANDARD SPECIFICATIONS FOR CONSTRUCTION DATED 1990, AS APPROVED BY THE FEDERAL HIGHWAY ADMINISTRATION ON MARCH 15, 1990 FOR USE ON THIS PROJECT, INCLUDING ALL SUBSEQUENT REVISIONS AND SUCH REVISED SPECIFICATIONS AND SPECIAL PROVISIONS AS ARE INCORPORATED IN THESE PLANS.

APPROVED _____ DATE _____
DIRECTOR OF PROJECT DEVELOPMENT

PROJECT NEWFANE
PROJECT NO. BHF 0106 (4) S
SHEET 1 OF 8 SHEETS