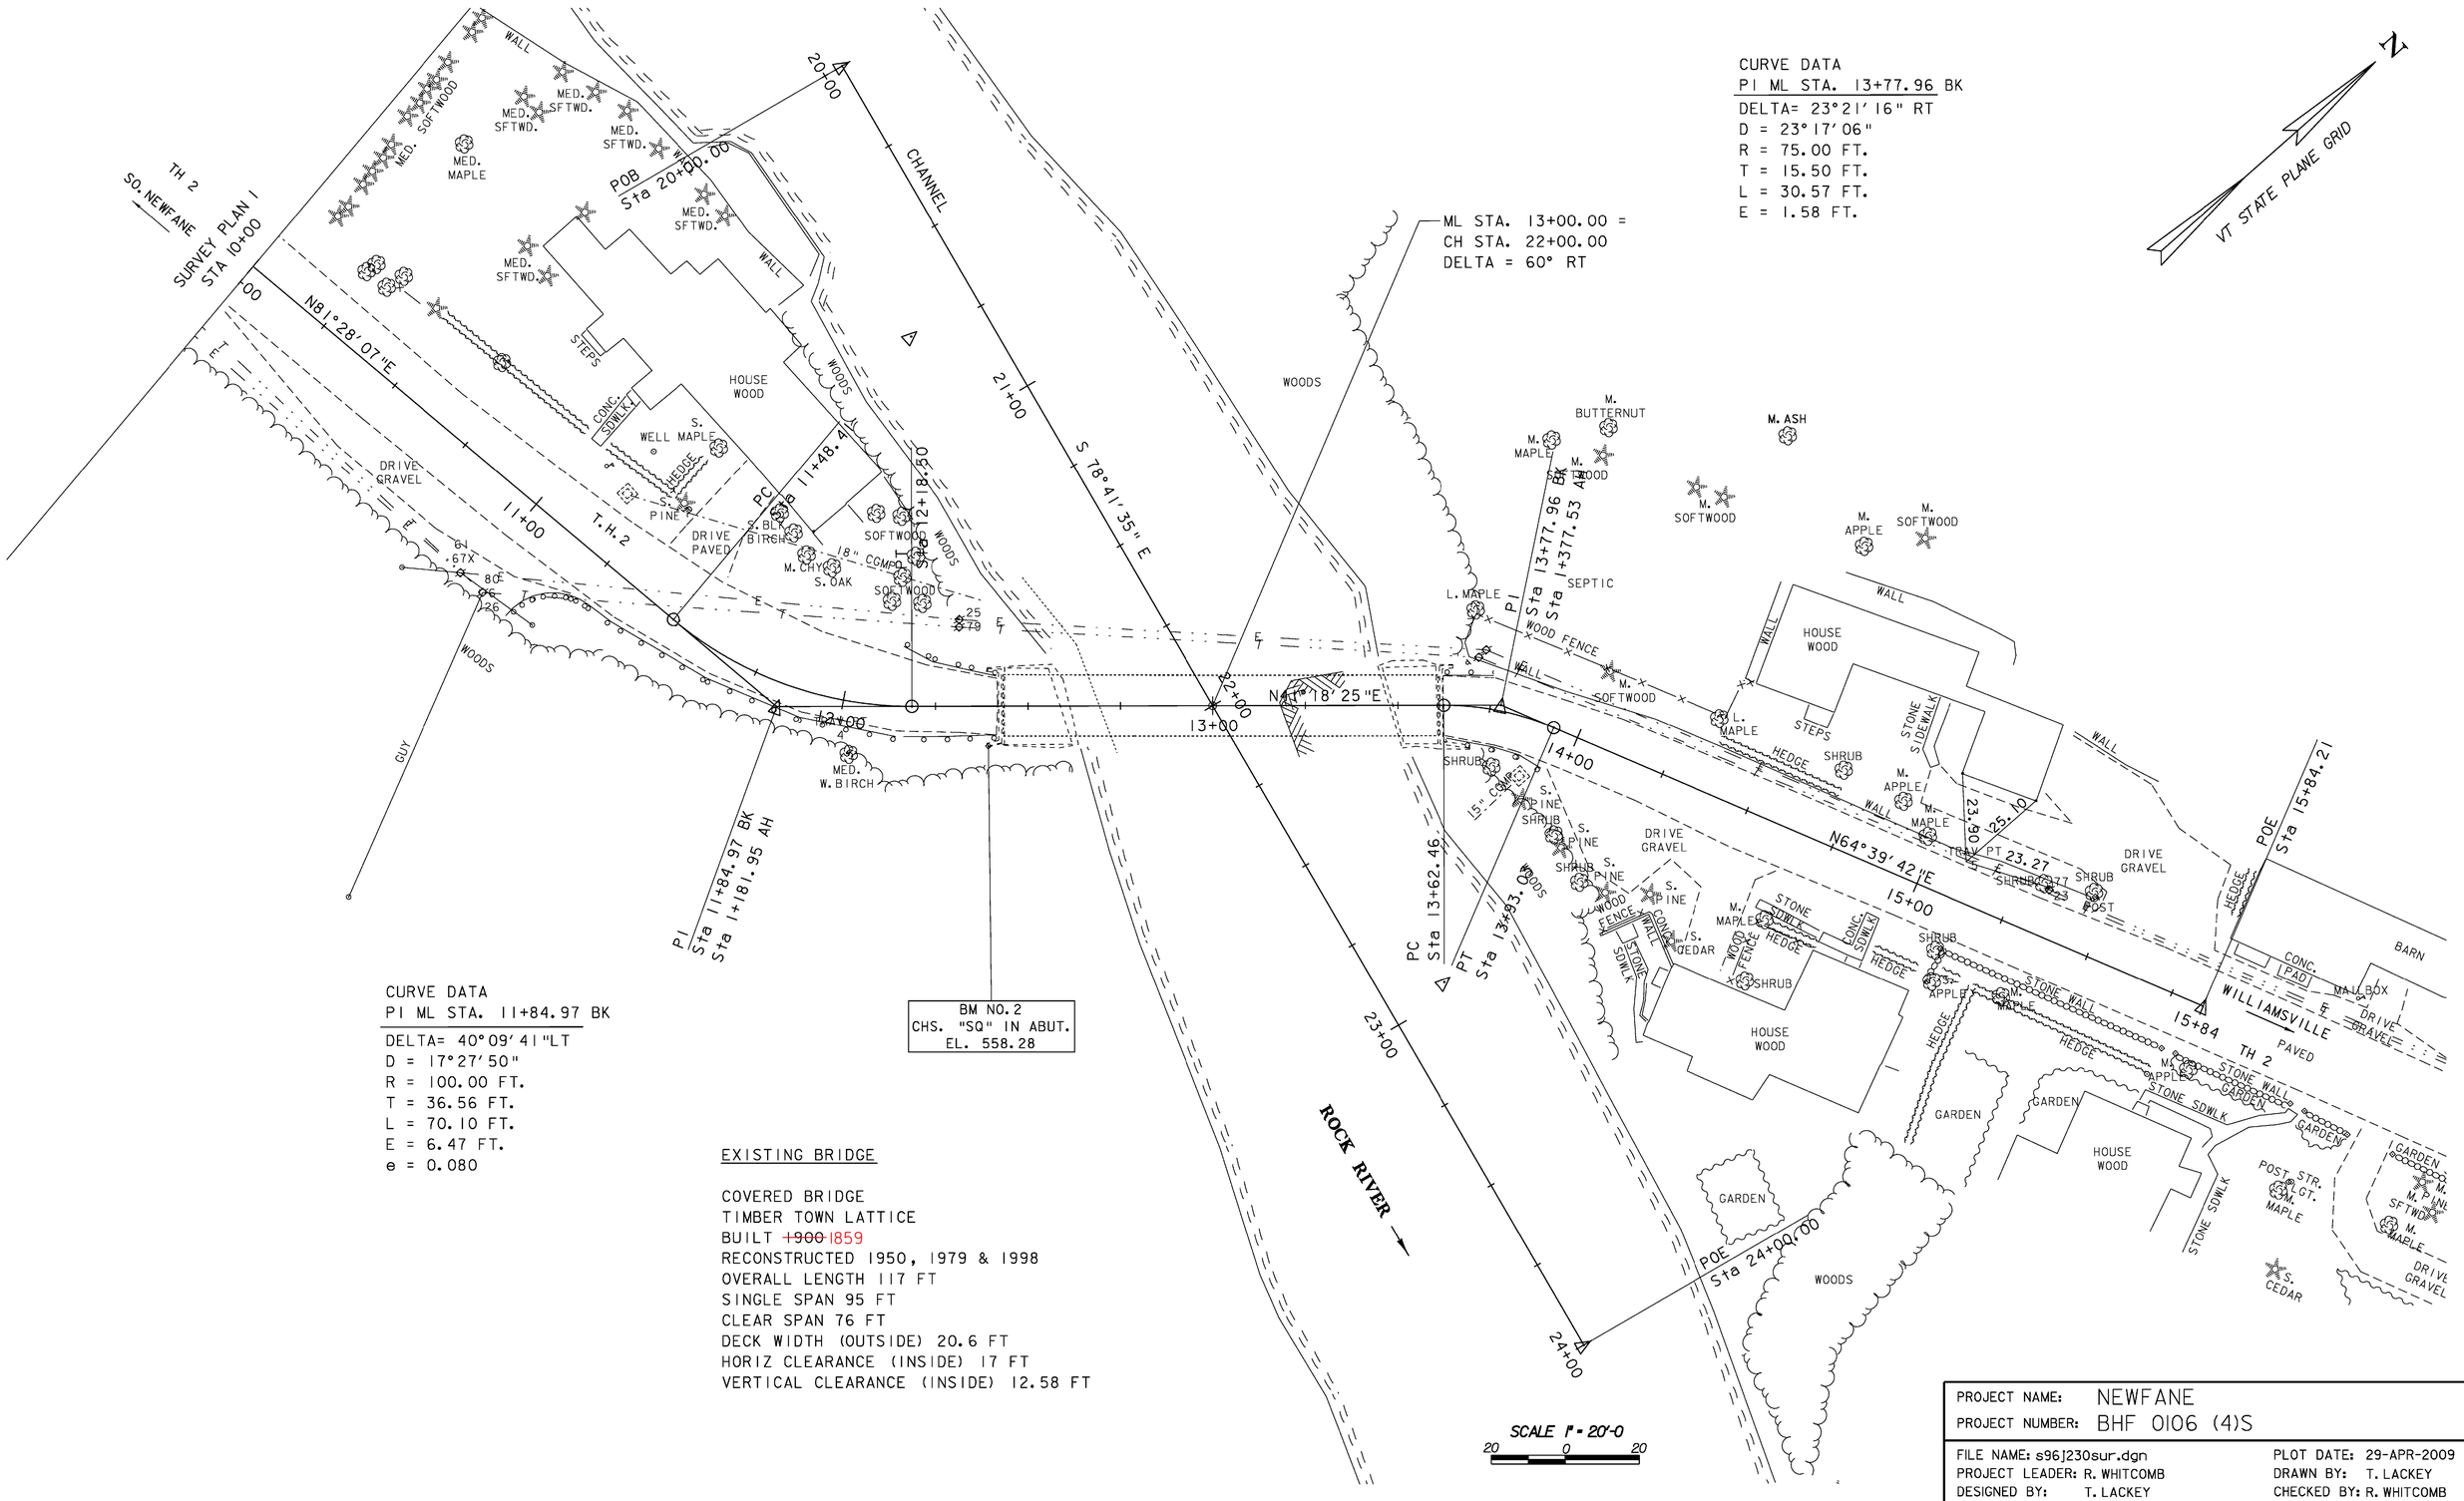

CURVE DATA
PI ML STA. 11+84.97 BK

DELTA= 40°09'41"LT
D = 17°27'50"
R = 100.00 FT.
T = 36.56 FT.
L = 70.10 FT.
E = 6.47 FT.
e = 0.080

EXISTING BRIDGE

COVERED BRIDGE
TIMBER TOWN LATTICE
BUILT ~~1900~~ 1859
RECONSTRUCTED 1950, 1979 & 1998
OVERALL LENGTH 117 FT
SINGLE SPAN 95 FT
CLEAR SPAN 76 FT
DECK WIDTH (OUTSIDE) 20.6 FT
HORIZ CLEARANCE (INSIDE) 17 FT
VERTICAL CLEARANCE (INSIDE) 12.58 FT

PROJECT NAME:	NEWFANE
PROJECT NUMBER:	BHF 0106 (4)S
FILE NAME: s96j230sur.dgn	PLOT DATE: 29-APR-2009
PROJECT LEADER: R. WHITCOMB	DRAWN BY: T. LACKEY
DESIGNED BY: T. LACKEY	CHECKED BY: R. WHITCOMB
SURVEY PLAN 2	SHEET 13 OF 67