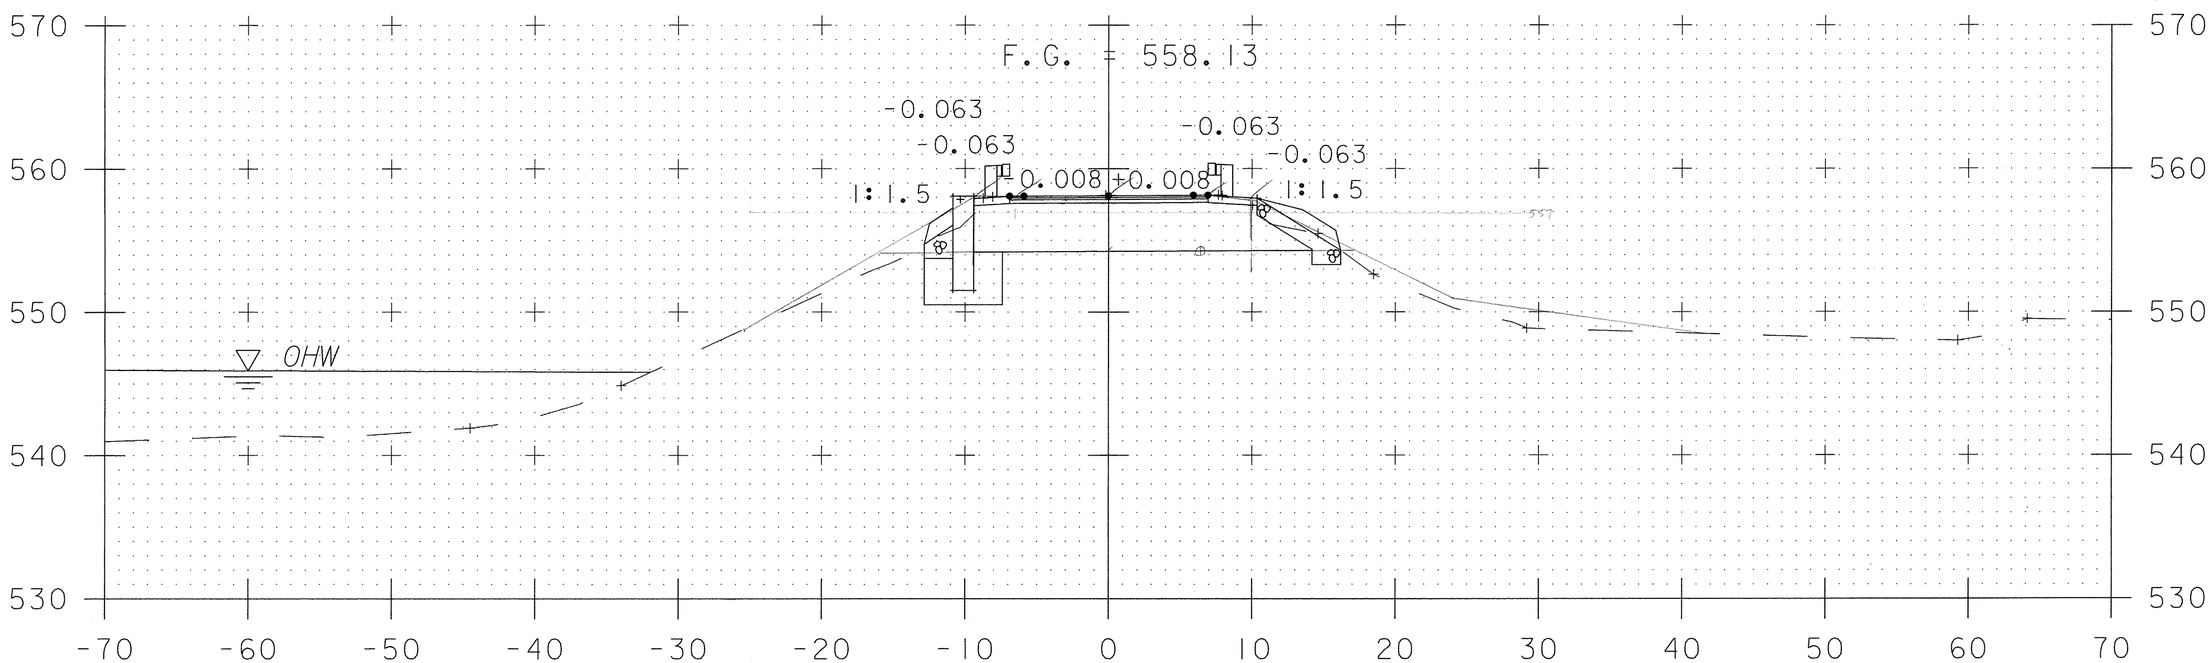

12+39

PROJECT NAME: NEWANE	
PROJECT NUMBER: BHF 0106 (4)S	
FILE NAME: s96J230conXsect.dgn	PLOT DATE: 14-OCT-2010
PROJECT LEADER: C. CARLSON	DRAWN BY: C. MOONEY
DESIGNED BY: T. LACKEY	CHECKED BY: T. LACKEY
MAINLINE CROSS SECTIONS STA. 12+39	SHEET 13 OF 14