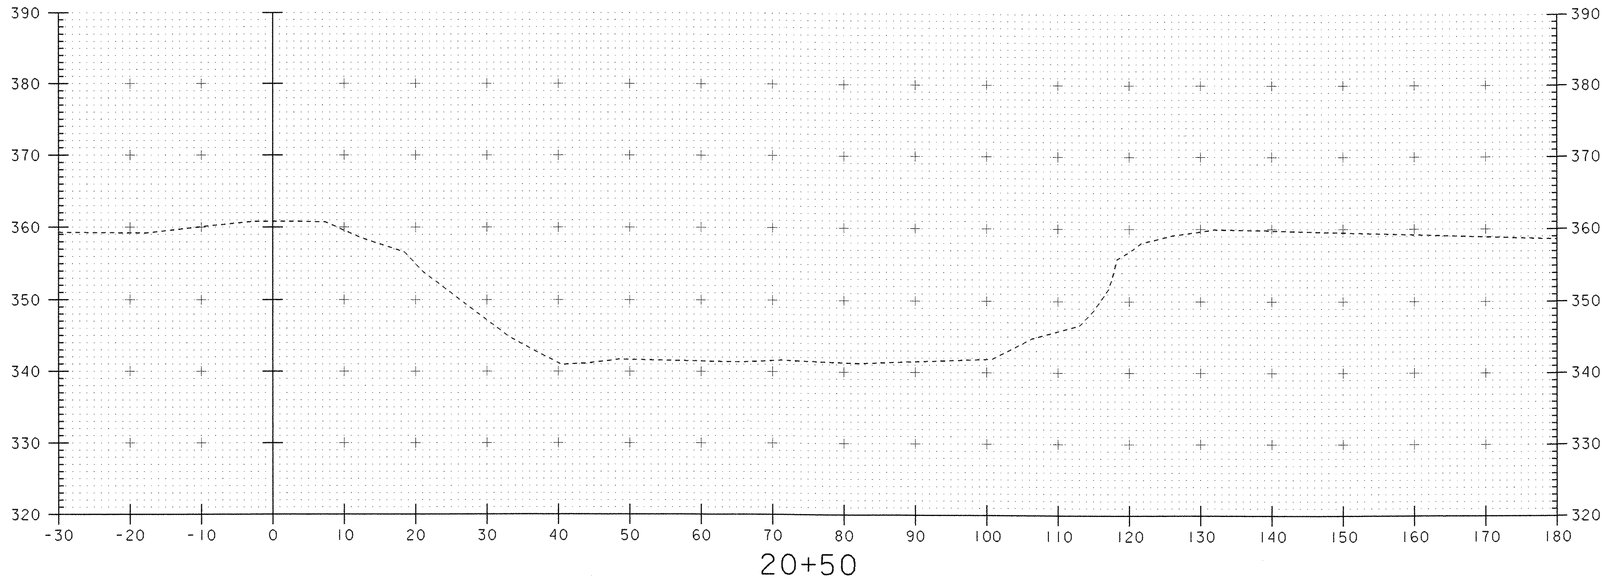

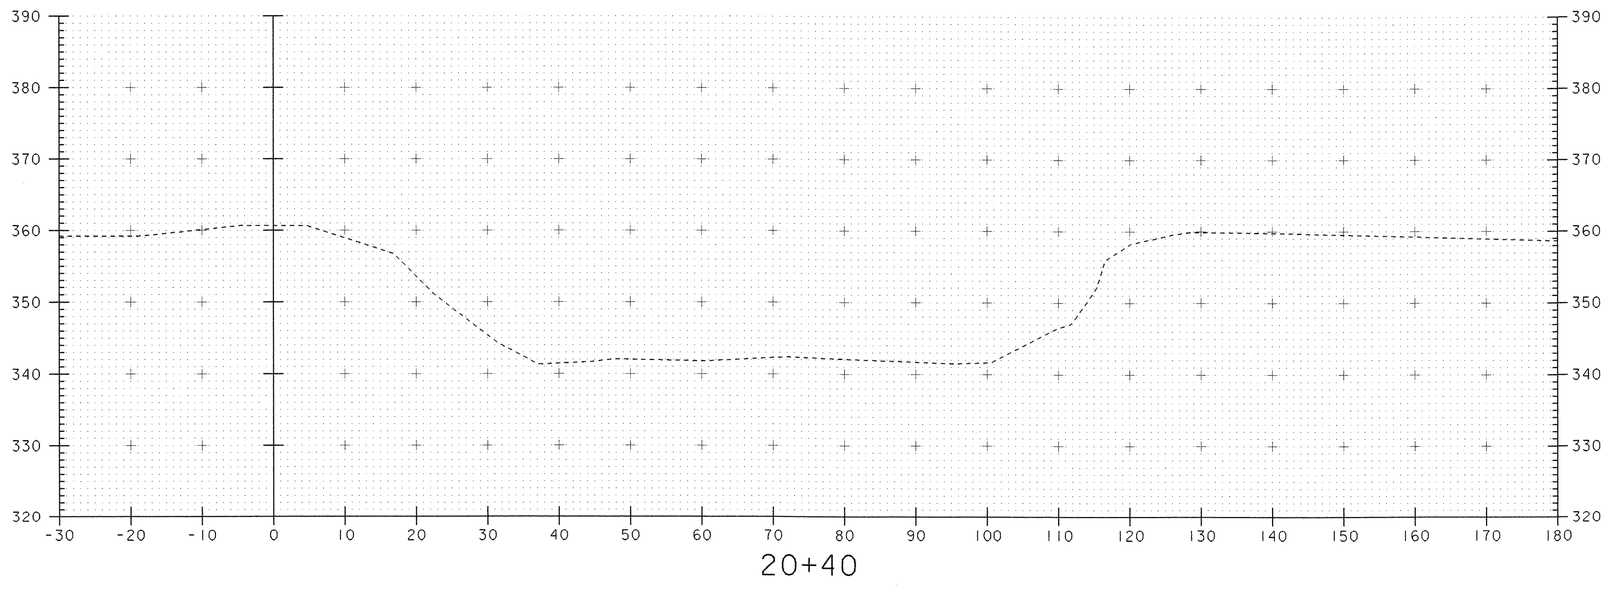

SCALE 1" = 10'-0
10 0 10

DATUM	
VERTICAL	NAVD 88
HORIZONTAL	NAD 83/92

PROJECT: PROCTOR - PITTSFORD	PROJECT NO.: BHO 1443 (3
DESIGN FILE NAME: 96J242\Structures\sj242esec.dgn	
IPARM FILE NAME: sj242ch3.i	PLOT DATE: 10-JAN-2
SURVEYED BY: L. ORVIS	SURVEY DATE: 02-02-
SQUAD LEADER: C.P. WILLIAMS	DRAWN BY: T. ANDERSC
CHANNEL CROSS SECTIONS	SHEET: 50 OF 60