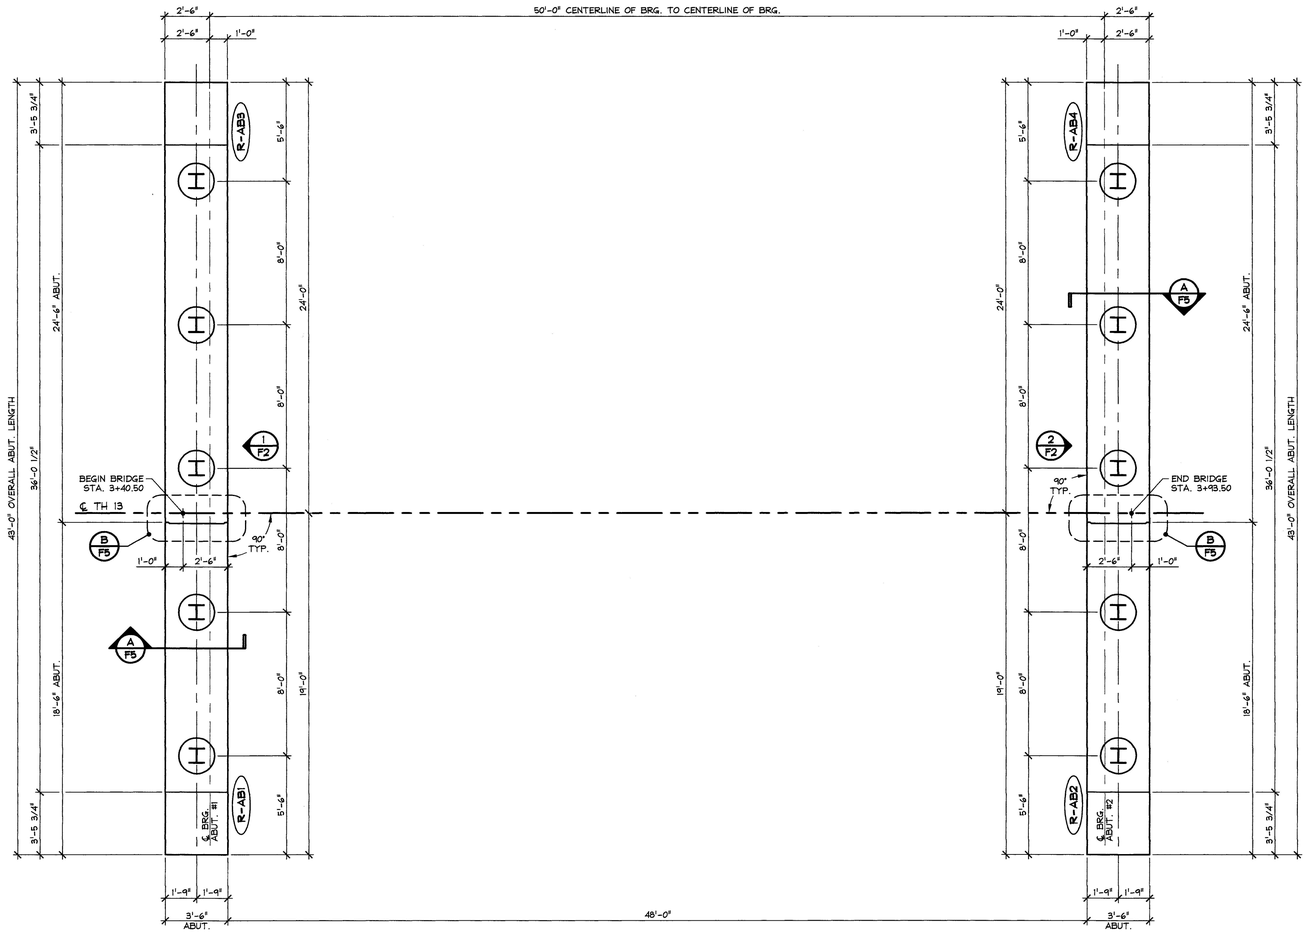

1 / F1 PRECAST ABUTMENT LAYOUT

1/4" = 1'-0"

Vermont Agency of Transportation

RECEIVED

23430-14 Forest Str_Rutland_rev1a.pdf

CK'D BY M. Umberger OK'D BY C. Carlson

July 1, 2014

RESUBMIT No Approved

BY C. Carlson DATE 07/08/2014

APPROVAL STAMP:	J.P. CARRARA & SONS INC. Precast & Prestress Manufacturer 2464 CASE STR., MIDDLEBURY, VERMONT 05753 Phone:(802)388-6361 Fax:(802)388-9010	THE BELDEN COMPANY, INC. CONTRACTOR RUTLAND, VERMONT
	STATE OF VERMONT AGENCY OF TRANSPORTATION COUNTY OF RUTLAND	DATE: APR. 25, 2014 SCALE: NOTED
	CITY OF RUTLAND ROUTE NO.: TH 13 (FOREST STREET) - URBAN COLLECTOR BRIDGE NO.: 14 PROJECT NO.: BRF 3000(18)	CHKD: M.D. DFTM: B.L. JOB NO: 23430-014
	PRECAST ABUTMENT LAYOUT	DWG. NO: F1

F:\VT-Bridges\23430-14 Rutland\23430-F1.dwg, 6/11/2014 4:46:17 PM