STATE OF VERMONT
AGENCY OF TRANSPORTATION

TRAFFIC SIGN SUMMARY SHEET

MILEMARKER, STATION, OR SIGN NUMBER	SIGN LEGEND	SIGN DIMENSIONS EA	WIDTH (in)	HEIGHT (in)	NEW & SALVAGED SIGNS "A"	"B"	SALV SIGN	SALV TIS	EXIST POST RETAIN	SALVAGE	NEW SIGN POSTS NO. OF POSTS	FLANGED CHANNEL lb/ft 1.12	2.0	3.0	SQUARE STEEL (in) lb/ft 1.75 1.88	2.0 2.42	2.5 3.35	ANCHOR	SLEEVE	TUBULAR ALUMINUM Ø (in) lb/ft 3.0 1.3	4.0 1.7	4.0 MOD 1.7	TUBULAR STEEL Ø (in) FOUND-ATION	lb/ft 3.0 7.6	3.5 9.0	4.0 10.8	5.0 14.6	W-SHAPE STEEL FTG. SIZE 24"	30"	WEIGHT	POST SIZE	SIGN FRAME REQUIRED	REMARKS	SIGN DETAIL DETAIL ON SHEET NUMBER	STD. SHEET NUMBER
	OPTION ITEMS																																			
9+79 LT. 10+17 RT. 13+35 LT. 13+81 LT.	10-0"	4	36	36	36.00						8					X		X															W12-2		SHS
	LEGAL LOAD LIMIT 16,000 POUNDS	4	24	30	20.00																											VR-017		E-141
9+76 LT. 10+23 RT. 13+XX LT. 14+XX LT.	ONE LANE BRIDGE	4	36	36	36.00						4					X		X															W5-3		SHS
10+87 LT. 12+87 RT.		2	12	36	6.0						2					X		X															OM3-L		SHS
10+87 RT. 12+87 LT.		2	12	36	6.0						2					X		X															OM3-R		SHS
												FT	FT	FT	FT	FT 224.0	FT		EA	LB	LB	LB		LB	LB	LB	LB								
TOTALS		SF 104.0	SF	EA.	SF		FT		FT 224.0		LB		EA.		LB								EA.	EA.	LB										

FINAL POST LENGTHS ARE TO BE DETERMINED IN THE FIELD. POST SIZES ARE COMPUTED BASED ON INFORMATION FURNISHED ON THE STANDARD SHEETS AND THE VTRANS "SIGN POST DESIGN GUIDELINE."

SHS=2009 STANDARD HIGHWAY SIGNS

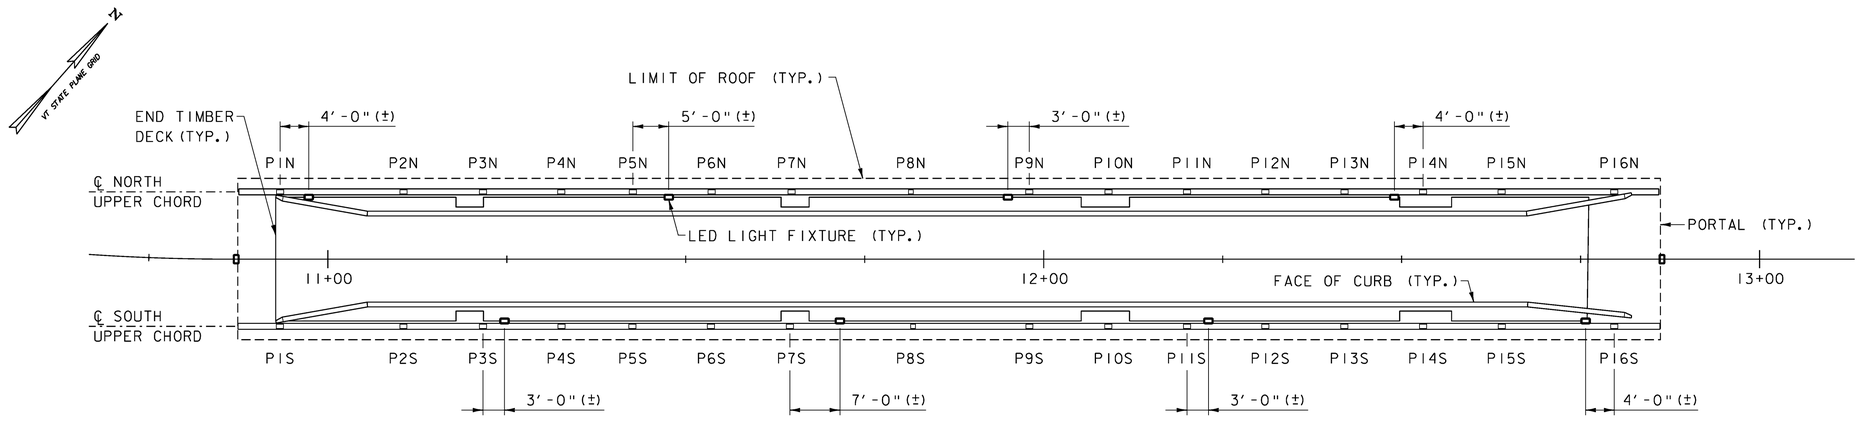

LIGHTING PLAN

SCALE: 1" = 10'

TOTAL FIXTURES = 10

NOTES

1. ALL COSTS ASSOCIATED WITH INCORPORATING A NEW LED BRIDGE LIGHTING SYSTEM SHALL BE INCLUDED IN ITEM 900.645 SPECIAL PROVISION (LIGHTING FOR COVERED BRIDGE).

McFarland Johnson

PROJECT NAME:	WOODSTOCK	WOODSTOCK
PROJECT NUMBER:	BHO 1444(52)	ST 1444(58)
FILE NAME: z96j262sgn.dgn		PLOT DATE: 29-JUN-2012
PROJECT LEADER: M. Sargent		DRAWN BY: P. Dustin
DESIGNED BY: P. Dustin		CHECKED BY: R. Joy
SIGN SUMMARY AND LIGHTING DETAILS		SHEET 62 OF 68