



VT. STATE PLANE GRID

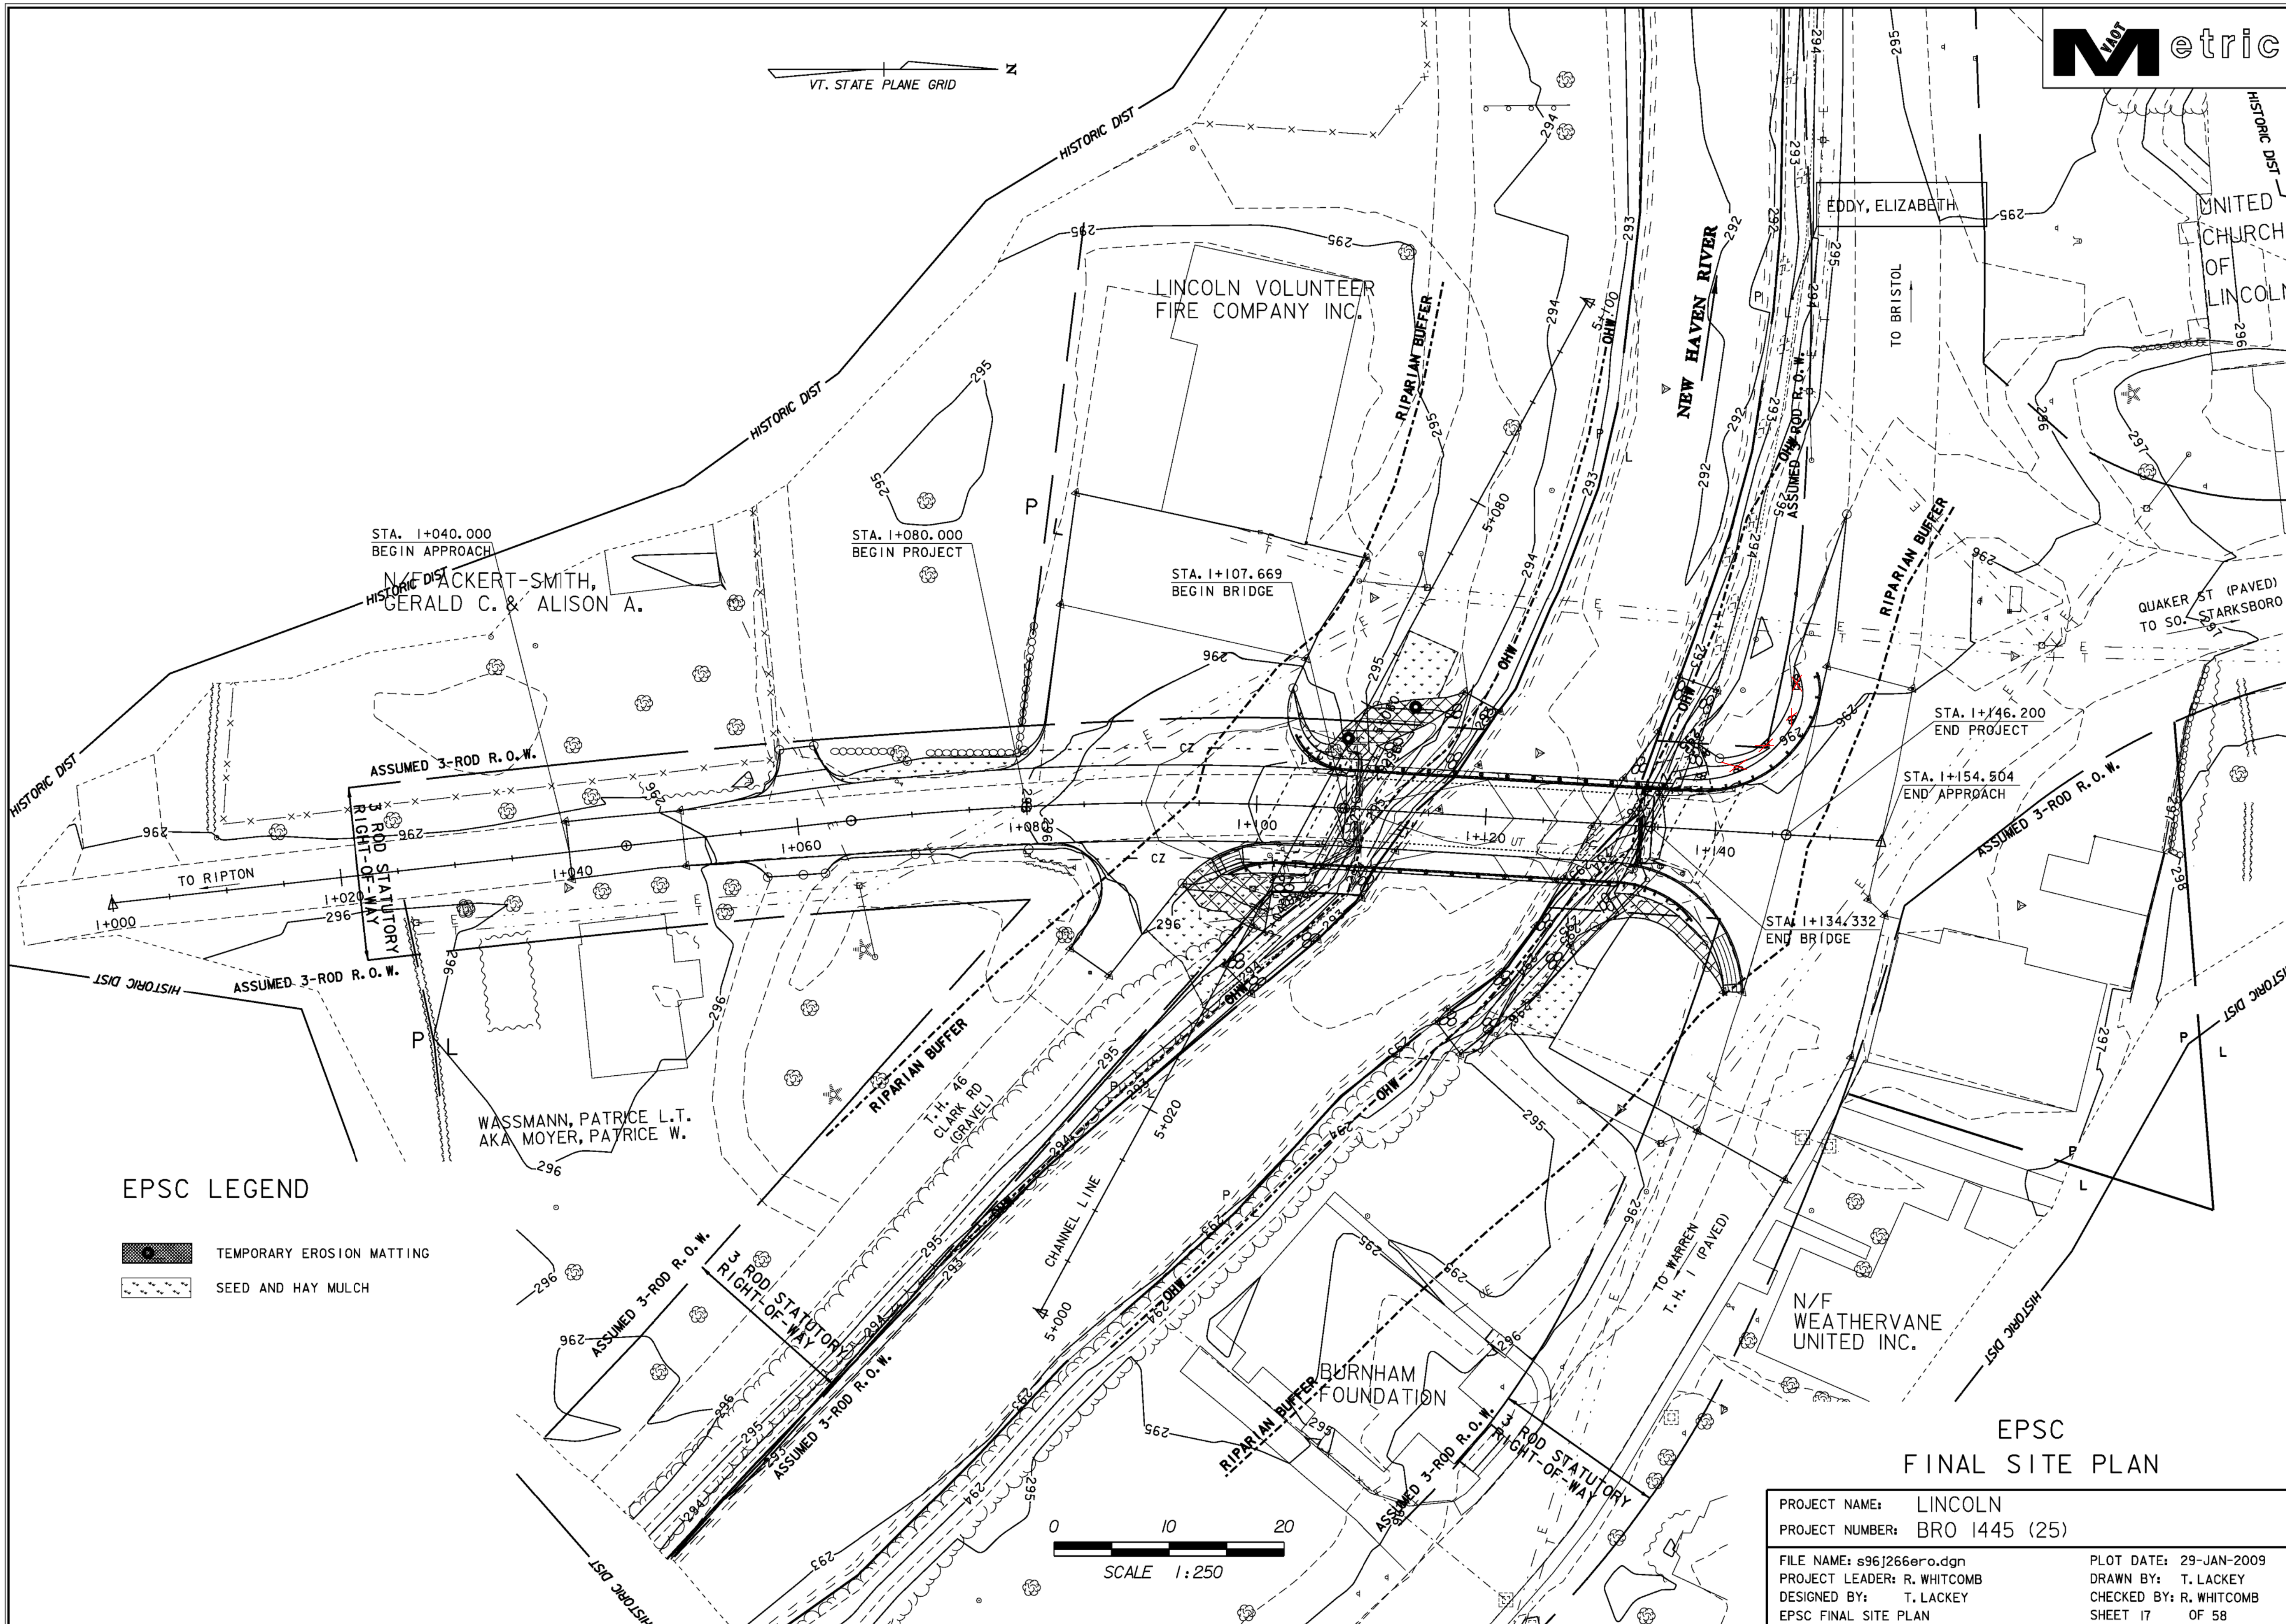

**EPSC LEGEND**

- TEMPORARY EROSION MATTING
- SEED AND HAY MULCH

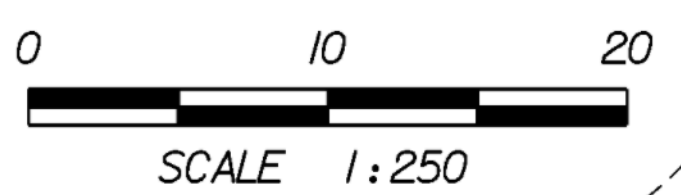

**EPSC  
FINAL SITE PLAN**

PROJECT NAME:	LINCOLN	PLOT DATE:	29-JAN-2009
PROJECT NUMBER:	BRO 1445 (25)	DRAWN BY:	T. LACKEY
FILE NAME:	s96j266ero.dgn	CHECKED BY:	R. WHITCOMB
PROJECT LEADER:	R. WHITCOMB	SHEET	17 OF 58
DESIGNED BY:	T. LACKEY		
EPSC FINAL SITE PLAN			