PROFILE ALONG T.H. 1/T.H. 3 CENTERLINE

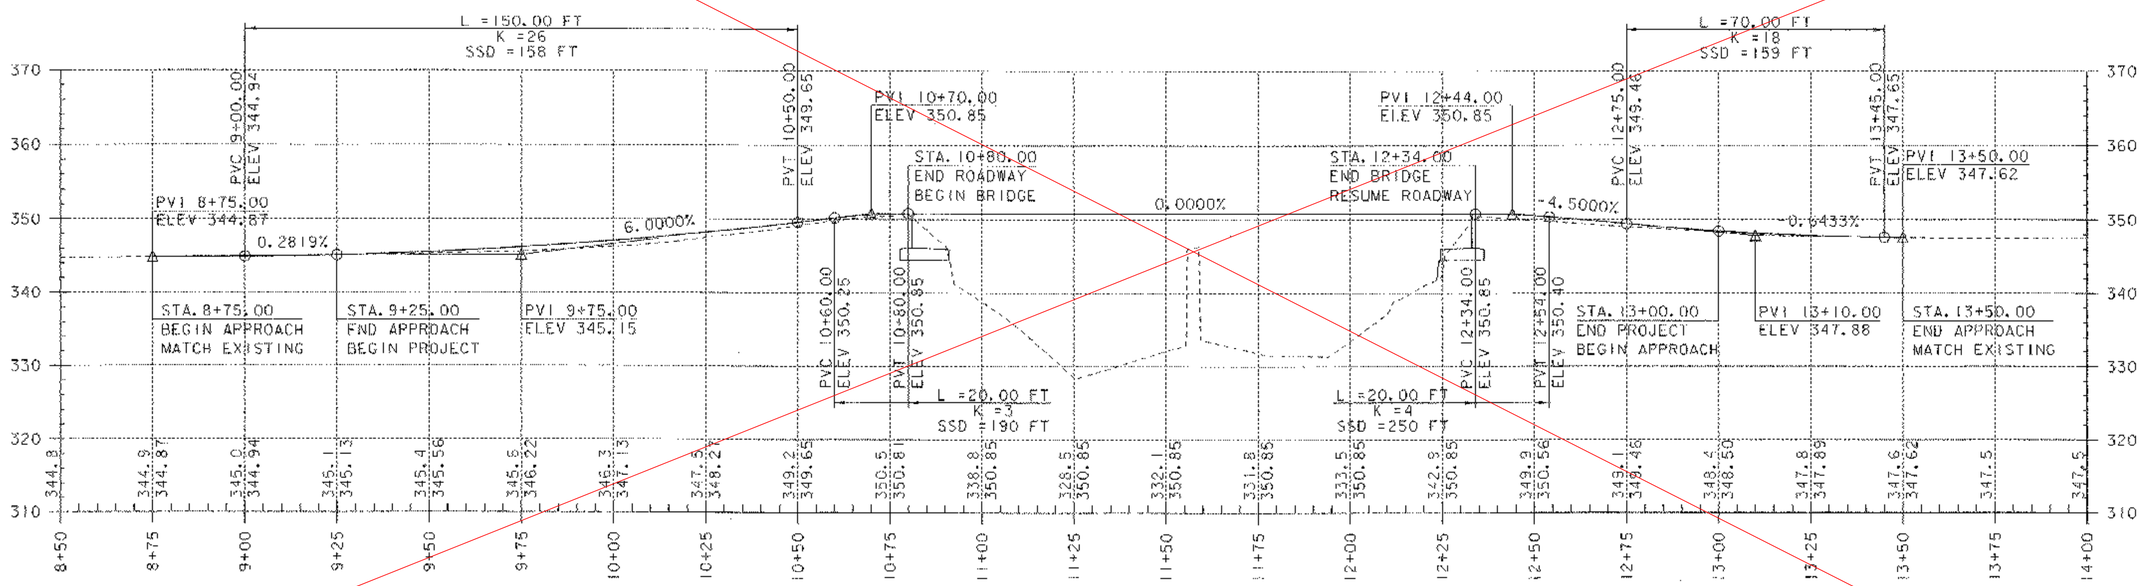

NOTE:
ELEVATIONS SHOWN TO THE NEAREST TENTH
ARE EXISTING GROUND ALONG PROPOSED CENTERLINE.
ELEVATIONS SHOWN TO THE NEAREST HUNDREDTH
ARE FINISH GRADE ALONG PROPOSED CENTERLINE.

SEE REVISED SHEET

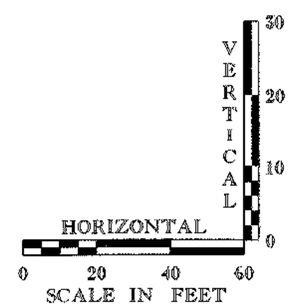

PROFILE

PROJECT NAME: SALISBURY - CORNWALL
PROJECT NUMBER: BHO 1445 (27)

FILE NAME: 96j268\Structures\sj268prf.i
PROJECT MANAGER: R.R. WHITCOMB
DESIGNED BY: G. ROY

PLOT DATE: 02-APR-2007
DRAWN BY: G. ROY
CHECKED BY: C. CARLSON
SHEET 9 OF 60