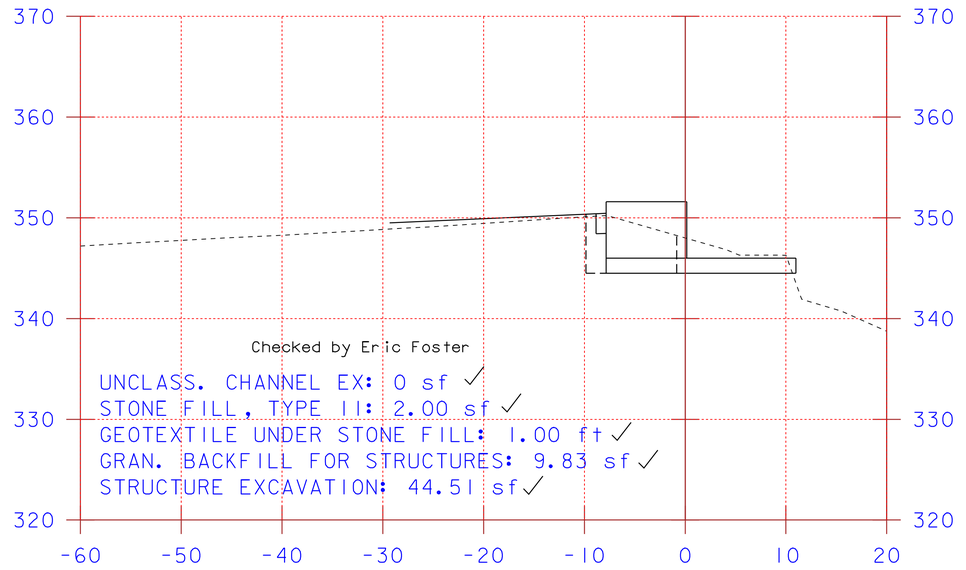

ABUTMENT #1
SCALE: 1"=10'

4+90.3

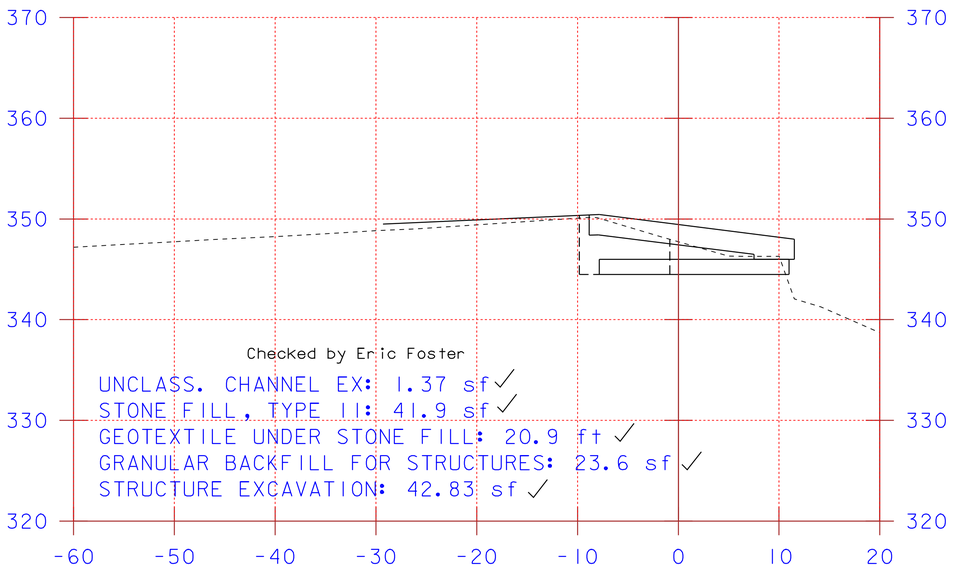

ABUTMENT #1
SCALE: 1"=10'

4+89.9 behind

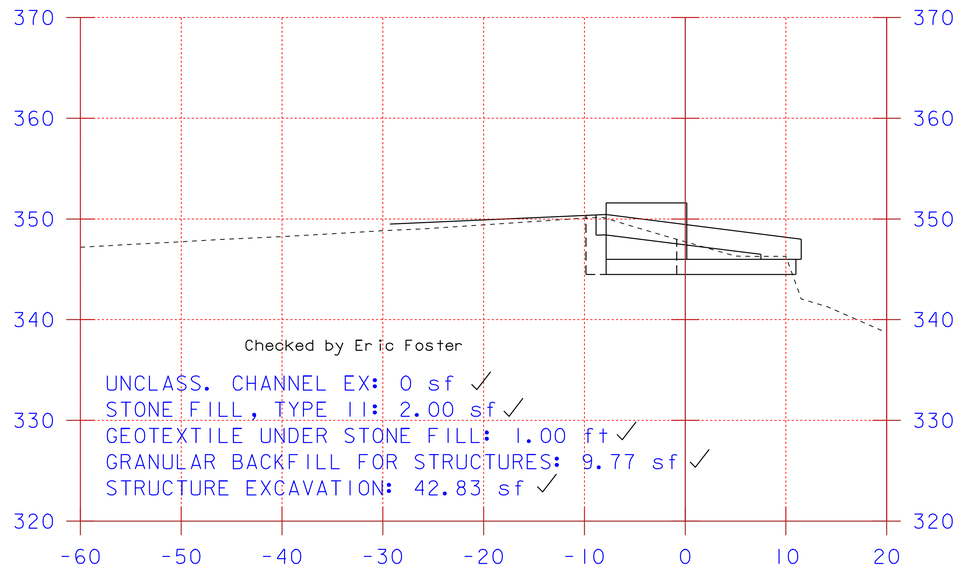

ABUTMENT #1
SCALE: 1"=10'

4+89.9 ahead

PROJECT NAME:	SALISBURY - CORNWALL
PROJECT NUMBER:	BHO 1445 (27)
FILE NAME: 96J268\Structures\sj268m01.i	PLOT DATE: 19-OCT-2009 09:5
PROJECT MANAGER: R.R. WHITCOMB	DRAWN BY: G. ROY
DESIGNED BY: G. ROY	CHECKED BY: C. CARLSON
STA. 8+75 - STA. 9+50	SHEET 63 OF 60