Metric

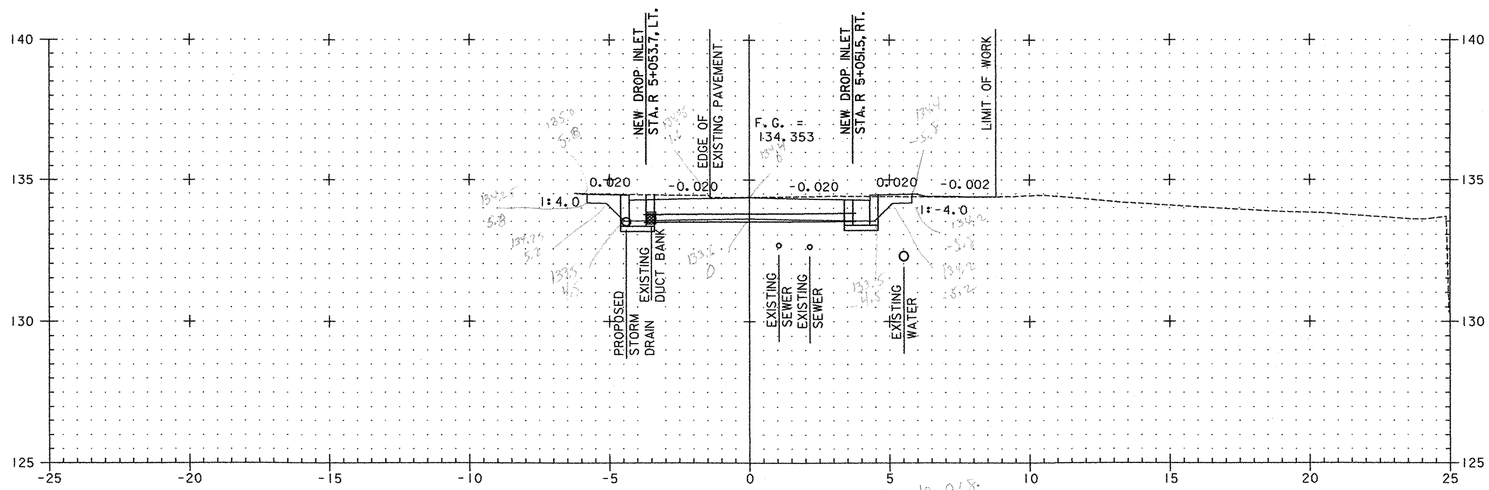

R 5+050
RELOCATED RAILROAD ST.

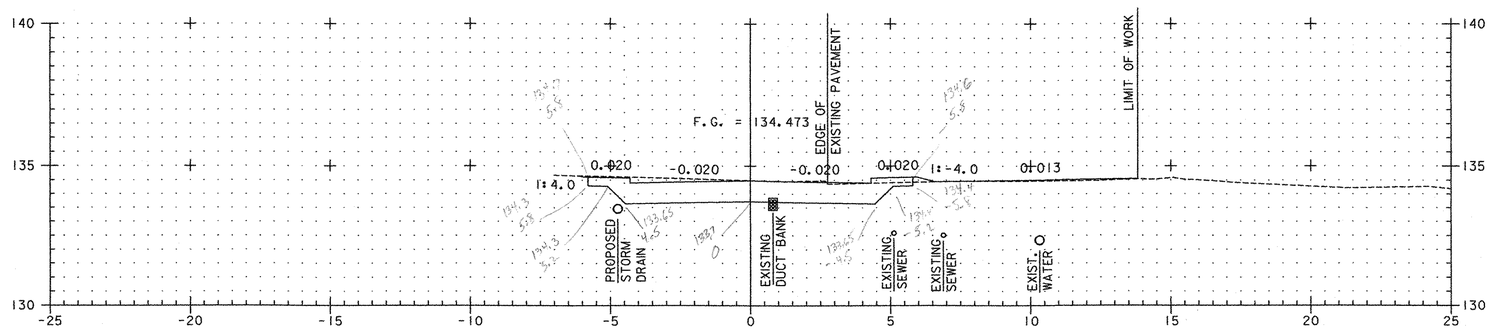

R 5+040
RELOCATED RAILROAD ST.

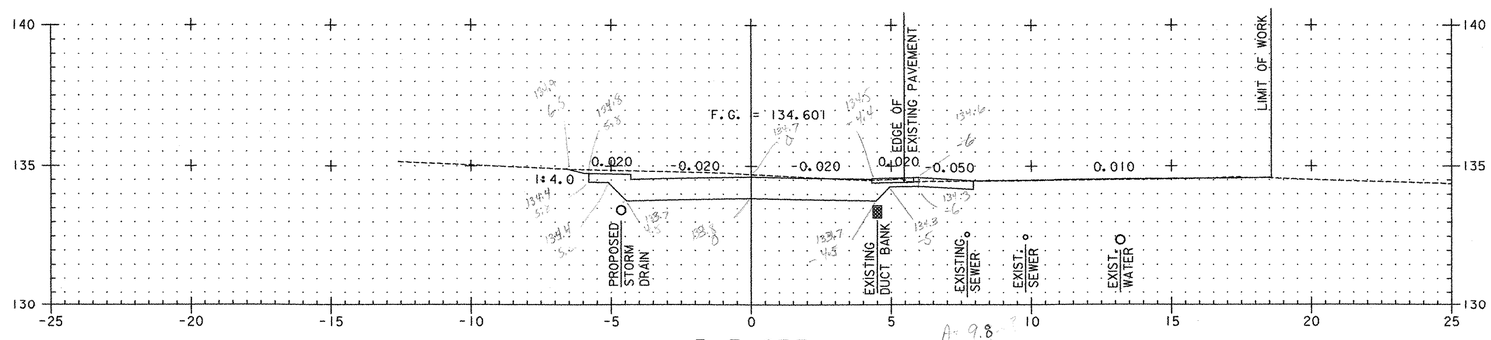

R 5+035
RELOCATED RAILROAD ST.

0 5 10
GRAPHIC SCALE 1:100

PROJECT NAME: WATERBURY	
PROJECT NUMBER: BRO 1446(26)	
FILE NAME: ...\49-59 sections.ptf	PLOT DATE: 01/26/2004
PROJECT LEADER: G EDWARDS/R GINGRAS	DRAWN BY: M MEILLEUR
DESIGNED BY: M MEILLEUR	CHECKED BY: R GINGRAS
RAILROAD STREET CROSS SECTIONS	SHEET 54 OF 63

...Districts\49-59 sections.dgn 01/26/2004 08:19:27 AM