Metric

9.14 cm stairway

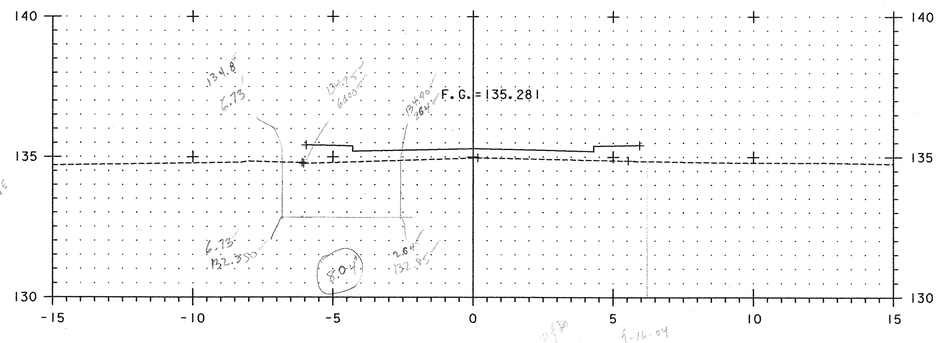

1+089

Begin Structure Exc. 1+089.145 @ 132.85
M S E Wall Left

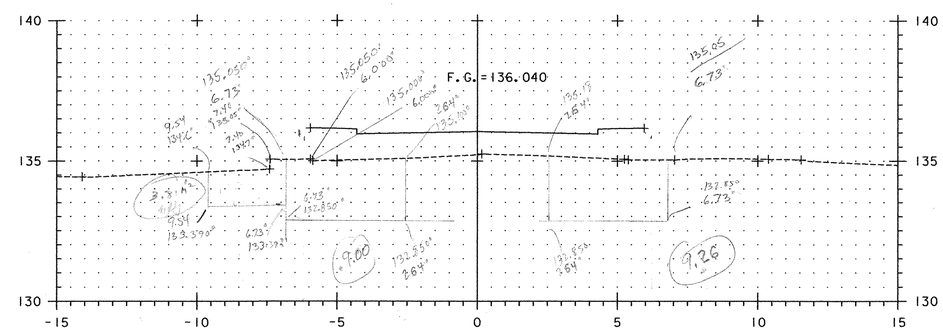

1+097

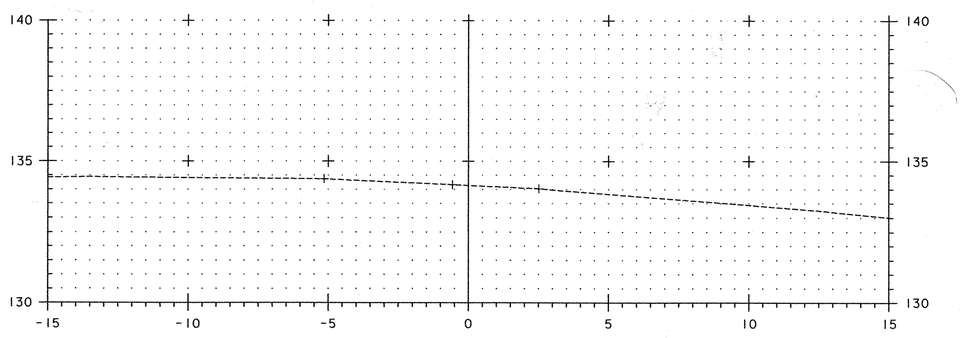

1+000

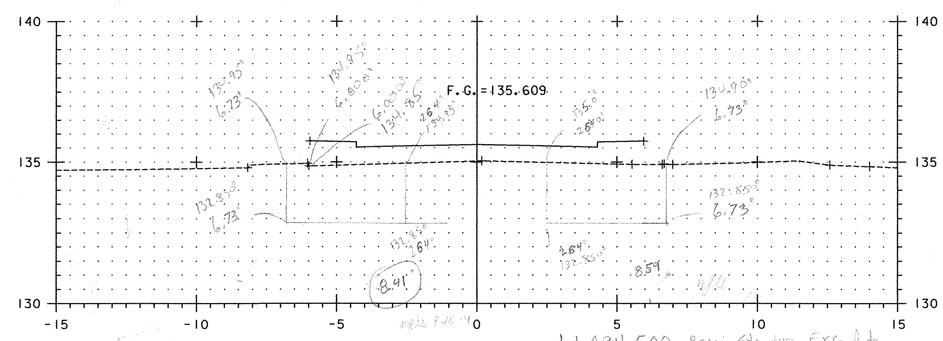

1+094.500 Begin Structure Exc Rt.

1+093

SCALE 1:100

PROJECT NAME: WATERBURY	
PROJECT NUMBER: BRO 1446(26)	
FILE NAME: ...\SSB-SupXS.dgn	PLOT DATE: 05/14/2004
PROJECT LEADER: G EDWARDS/R GINGRAS	DRAWN BY: T. KNIGHT
DESIGNED BY: T. KNIGHT	CHECKED BY:
SUPPLEMENTAL CROSS SECTIONS	SHEET 1 OF 6

Dufresne-Henry

078 AS