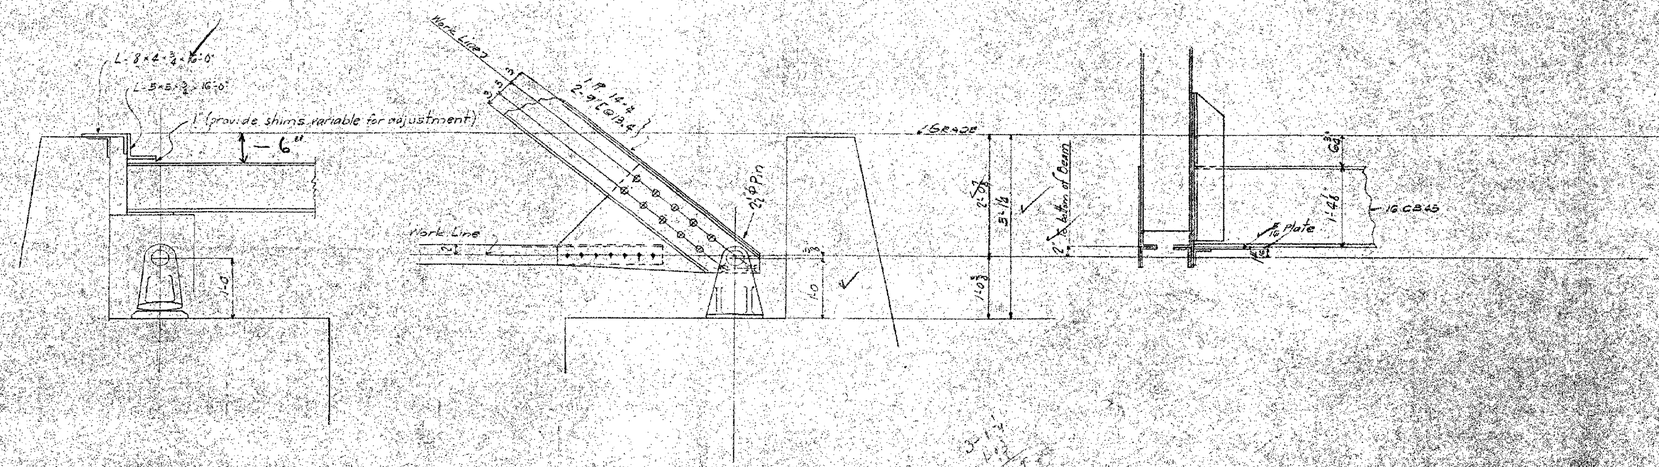

RIVET	HOLES	CONTENTS OF SHEET		NAME OF STRUCTURE: CREAMERY BRIDGE BRADFORD, VT.	DATE 1/16	AMERICAN BRIDGE COMPANY Ambridge PLANT
3/4"	13/16"					ORDER No. / SHEET No.

PROJECT: BRADFORD	PROJECT NO.: STP 1447 (28)
DESIGN FILE NAME: 96j286/structures/s96j286ref.dgn	
IPARM FILE NAME: s96j286ref5.i	PLOT DATE: 22-NOV-2006
DESIGNED BY:	DRAWN BY: J. WHITE
SQUAD LEADER: C.P. WILLIAMS	CHECKED BY: M.FESSEL
REFERRENCE SHEET	SHEET: 57 OF 63