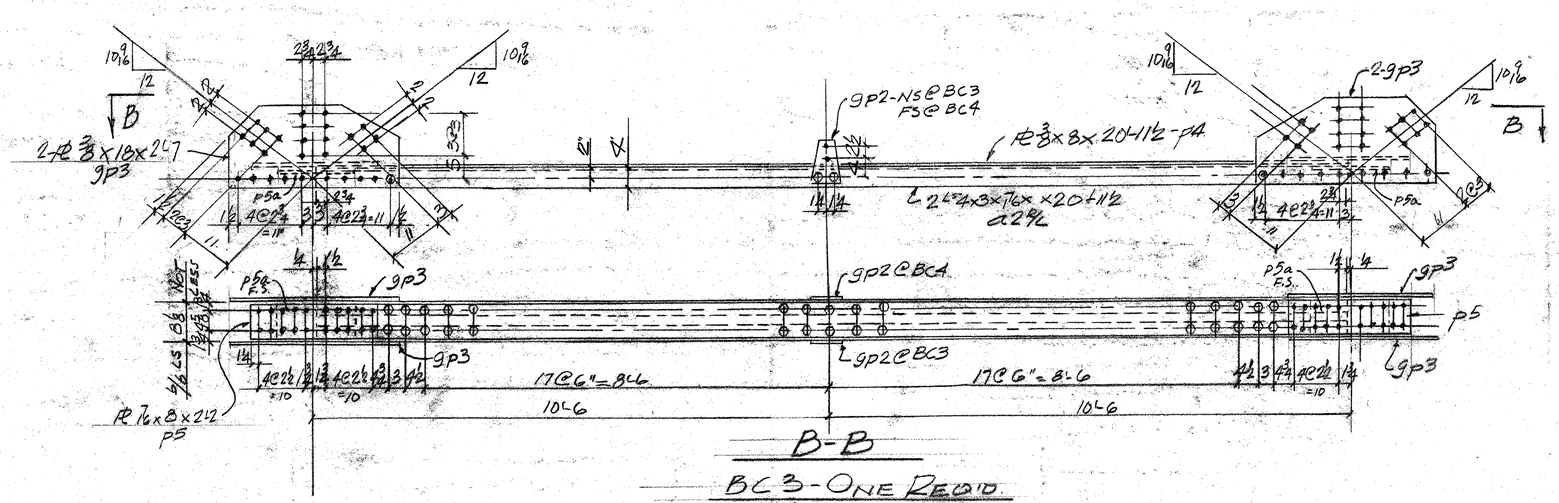

BC3 - ONE REQ'D
BC4 - ONE REQ'D

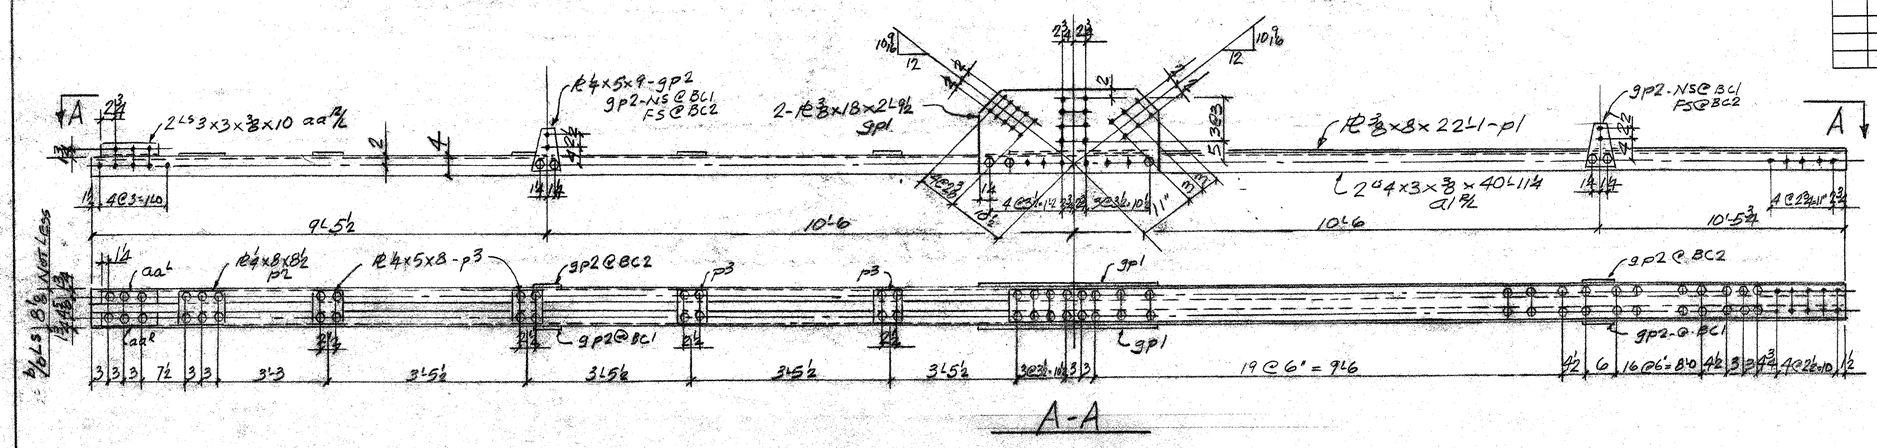

BC1 - 2 REQ'D
BC2 - 2 REQ'D

RECEIVED
CK'D BY ____ OK'D BY RSY
JUN 04 2007
RESUBMIT ____ APPROVED ✓
BY CPW DATE 6/6/07

ABM INFO		SHOP BILL						JOB NO. 314	DRG. NO. S1
PAGE	LINE	NO.	DESCRIPTION	FT	IN	ASSEM. MARK	SHIPPING MARK	REMARKS	WEIGHT
		1	LOWER CHORD	41	0 ±		BC1		—
		1	DO	41	0 ±		BC2		—
		8	L 4 x 3 x 3/8 (CVN)	40	11 1/4	aa 1 1/2		506.50	
		4	PL 3/8 x 8 (CVN)	22	1	p1		506.60	
		4	PL 4 x 8		8 1/2	p2			
		16	PL 4 x 5		8	p3			
		4	L 3 x 3 x 3/8		10	aa 1 1/2			
		8	PL 3/8 x 18	2	9 1/2	gp1			
		8	PL 1/4 x 5		9	gp2			
		16	7/8" BOLTS A325 CAD.		2	SHOP		W/N & WASH.	
		408	DO		24	DO		DO	
		1	LOWER CHORD	21	0 ±		BC3		—
		1	DO				BC4		—
		4	L 4 x 3 x 7/16 (CVN)	20	11 1/2			506.50	
		2	PL 3/8 x 8	20	11 1/2	p4		506.60	
		4	PL 7/16 x 8	2	2	p5			
		4	PL 3/8 x 6	1	3	p5a			
		8	PL 3/8 x 18	2	7	gp3			
		2	PL 4 x 5		9	gp2			
		4	7/8" BOLTS A325 CAD.		2	SHOP		W/N & WASH.	
		164	DO		24	DO			
			FIELD BOLTS (VERT. DIAG'S SPLICES - FLE. BAT CONN)						
		20	7/8" BOLTS A325 CAD.		2		FIELD	W/N & WASH.	
		328	DO		24		FIELD	DO	
		256	DO		22		FIELD	DO	
			PAY ITEMS - AS NOTED						

OUT FOR APPROVAL		3-22-07									
OUT FOR APPROVAL		4-24-07		5-31-07							
ISSUED TO SHOP											
FIELD & OFFICE											
REV.	REMARKS	DATE	DWN	CHK	APP	Q.A.	NO.	DIA.	LGT	TYPE	WASHER

PROJECT NO. STP 1447 (28) STATE PROJECT NO.

MATERIAL AASHTO M270-36 (GR50) ELECTRODES: — HOLES: 13/16" SHOP BOLTS: 7/8" A325 GALV.

SURFACE PREP. & PAINT: BLAST CLEAN - SP10
SHERWIN WILLIAMS - 2 COAT SYSTEM
PRIMER - COROTHENE I GALVAPAC
SECOND COAT - PASTCLAD URATHANE

DESCRIPTION: NEW LOWER CHORDS

JOB: IMPROVEMENTS CREAMERY BRIDGE BRADFORD, VT.

CUSTOMER: AUSTIN CONSTR.

	DRAWN BY	DATE
	JPF	3-07
	CHKD BY	
	EJ	
	APPROV BY	
	Q.A.	

CASCO BAY STEEL STRUCTURES, INC.
75 SPRING HILL ROAD SACO, MAINE 04072
PHONE (207) 282-7360 FAX. (207) 282-1179

JOB NO.	DRG. NO.
314	S1
	REV. 1

SS 6