STATE OF VERMONT
AGENCY OF TRANSPORTATION

TRAFFIC SIGN SUMMARY SHEET

MILEMARKER, STATION, OR SIGN NUMBER	SIGN LEGEND	SIGN DIMENSIONS EA	WIDTH (in)	HEIGHT (in)	NEW & SALVAGED SIGNS "A"	"B"	SALV SIGN	SALV TIS	EXIST POST RETAIN	SALVAGE	NEW SIGN POSTS NO. OF POSTS	FLANGED CHANNEL lb/ft 1.12	2.0	3.0	SQUARE STEEL (in) lb/ft 1.75 1.88	2.0 2.16	2.5 3.35	ANCHOR	SLEEVE	TUBULAR ALUMINUM Ø (in) lb/ft 3.0 1.3	4.0 1.7	4.0 MOD 1.7	FOUND-ATION	TUBULAR STEEL Ø (in) lb/ft 3.0 7.6	3.5 9.0	4.0 10.8	5.0 14.6	W-SHAPE STEEL FTG. SIZE 24"	30"	WEIGHT	POST SIZE	SIGN REQUIRED	REMARKS	SIGN DETAIL DETAIL ON SHEET NUMBER	STD. SHEET NUMBER
												OPTION ITEMS																								
W12-2	10'-8"	2	30"	30"	6.25						2			16 X																				X	E-155
W5-3	ONE LANE BRIDGE	2	30"	30"	6.25						-			~~X~~																				5	SEE BELOW
OM-3L		2	12"	36"	3.00						2 ~~1~~			10 X 10																				X	E-120
OM-3R		2	12"	36"	3.00						2 ~~1~~			10 X 10																				X	E-120
VR-017	LEGAL LOAD LIMIT 12,000 POUNDS	5	24"	30"	5.00						2 ~~1~~			14 X 14																					

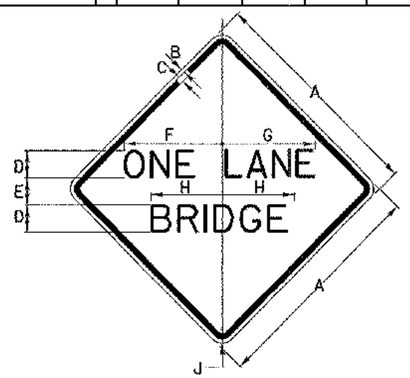

COLORS
LEGEND-BLACK (NON - REFL.)
BACKGROUND - YELLOW (REFL.)

SIGN	DIMENSIONS (INCHES) A	B	C	D	E	F	G	H	J
MIN.	30	1/2	3/4	5C	3 1/4	13 5/16	12 11/16	9 1/8	1 7/8
STD.	36	5/8	7/8	6C	4	16	15 1/4	11 1/2	2 1/4
SPECIAL	48	3/4	1 1/4	8C	5	21 1/4	20 1/4	15 3/8	3

FINAL POST LENGTHS ARE TO BE DETERMINED IN THE FIELD. POST SIZES ARE COMPUTED BASED ON INFORMATION FURNISHED ON THE STANDARD SHEETS AND THE TRAFFIC & SAFETY DIVISION'S 'SIGN POST DESIGN GUIDELINE.'

TOTALS	XX					FT	FT	FT	FT	FT	FT		EA	LB	LB	LB		LB	LB	LB	LB			
	SF 62.0	SF	EA.	SF		FT ~~166~~ 100			FT					LB			EA.	LB				EA.	EA.	LB

HTA consulting engineers
150 Dow Street - Manchester, NH 03101-1227
Tel:603-669-5555 Fax: 603-669-4618
184 South Winooski Ave. - Burlington, VT 05401
Tel:802-860-1331 Fax: 802-860-6499
Web Page: www.haytomasser.com E-Mail: hta@lite-rite.com

STATE OF VERMONT
AGENCY OF TRANSPORTATION

Town Of MONTGOMERY	Bridge No. 41
Highway No. 42	Log Sta. —
	Surv. Sta. —

COMSTOCK COVERED BRIDGE

TRAFFIC SIGN SUMMARY SHEET

Designed By JW.ROCKWELL	Drawn By J.D.GEER
Checked By S.T.JAMES Date 1-2003	Bridge Design Supervisor Date
PROJECT MONTGOMERY	PROJECT NO. BHO 1448(26)
L.G.C. Info. —	ZJ304TRF
Bridge Sheet No. 5	Sheet 5 of 18