



STA. 51+10 RT  
 END UNCLASSIFIED CHANNEL EXCAVATION  
 GEOTEXTILE UNDER STONE FILL  
 STONE FILL, TYPE IV  
 GRUBBING MATERIAL

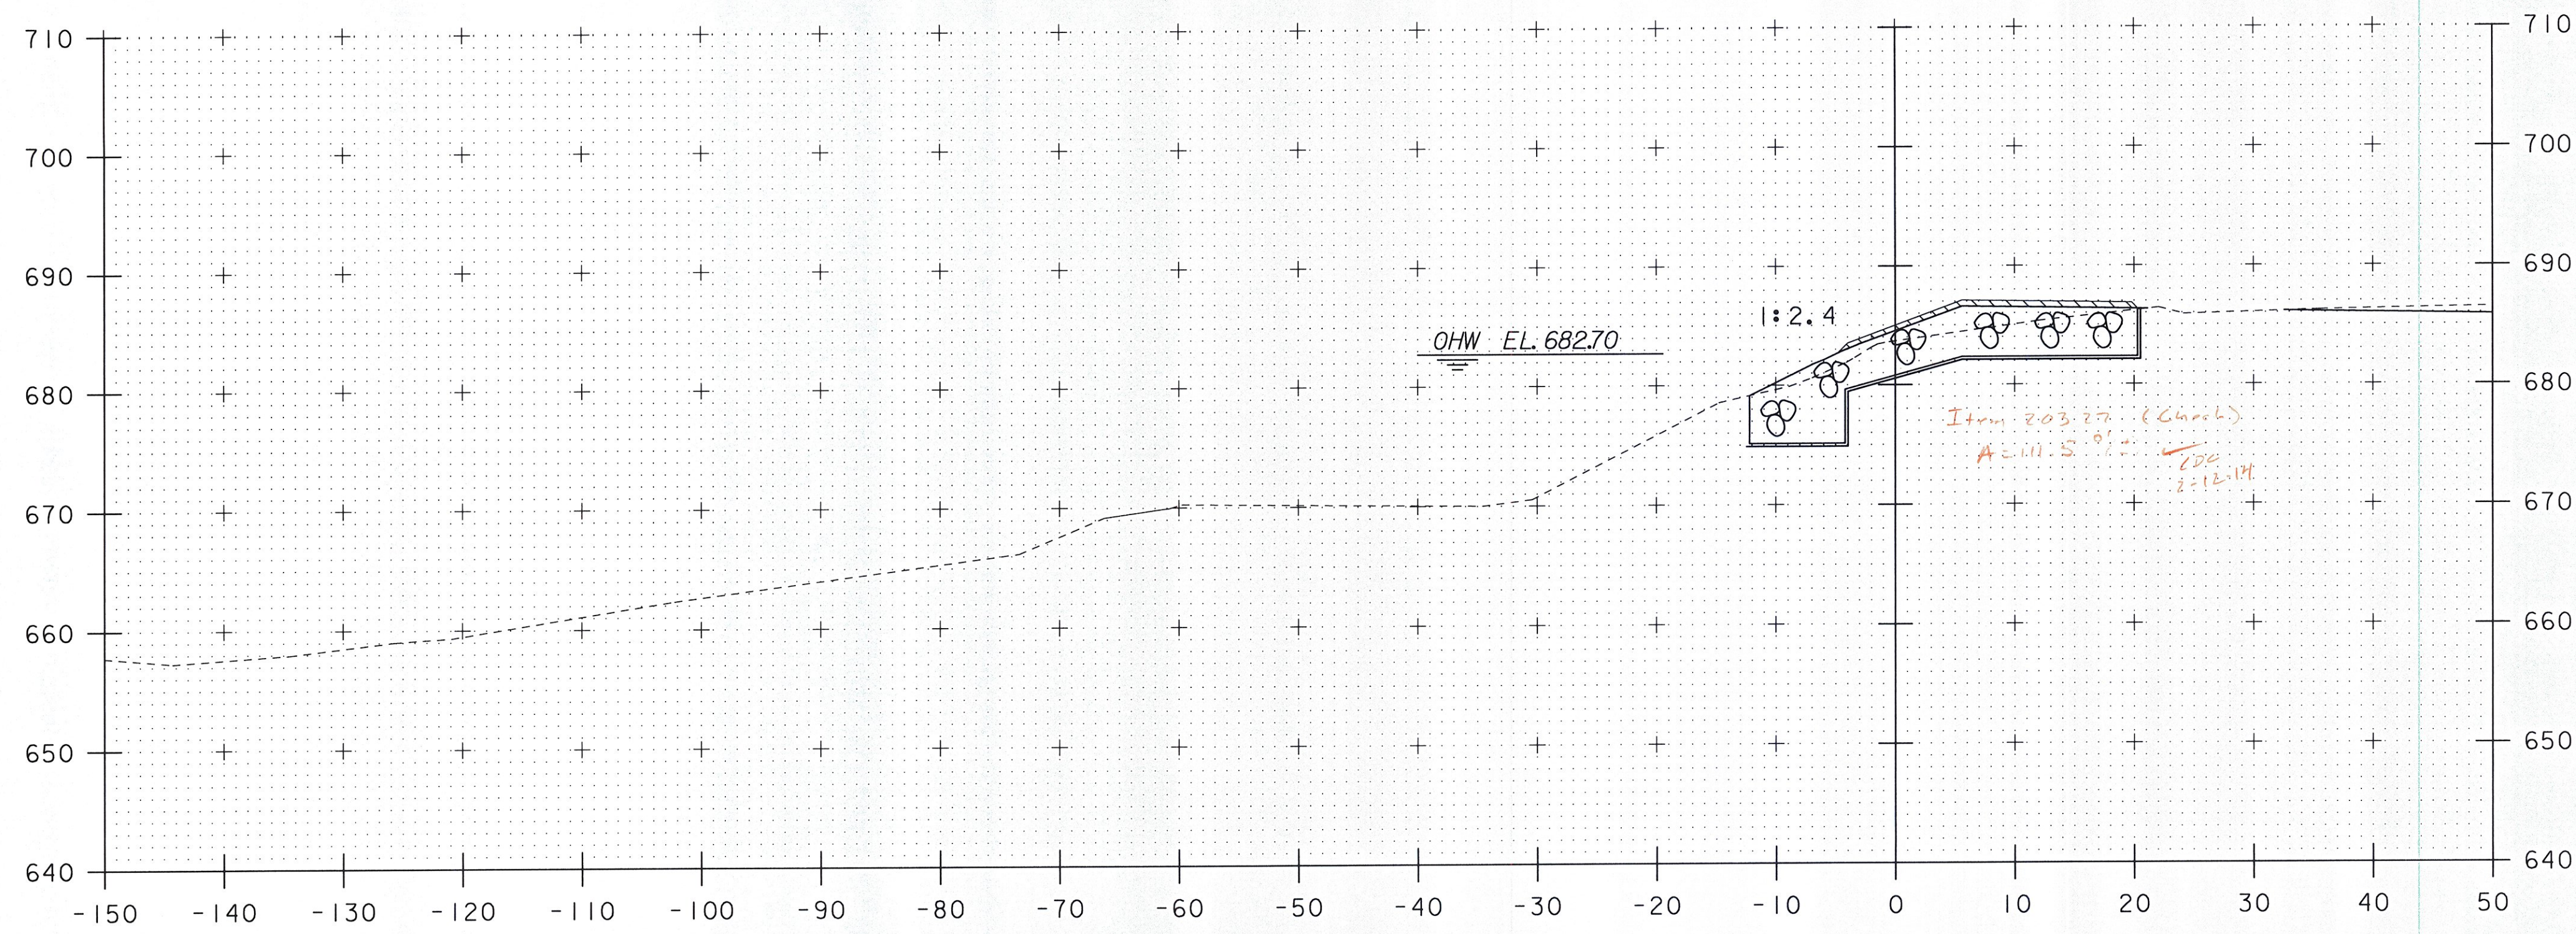

51+00

STA. 50+96 RT  
 END GRANULAR BACKFILL  
 FOR STRUCTURES  
 STA. 50+91 RT  
 BEGIN GRUBBING MATERIAL

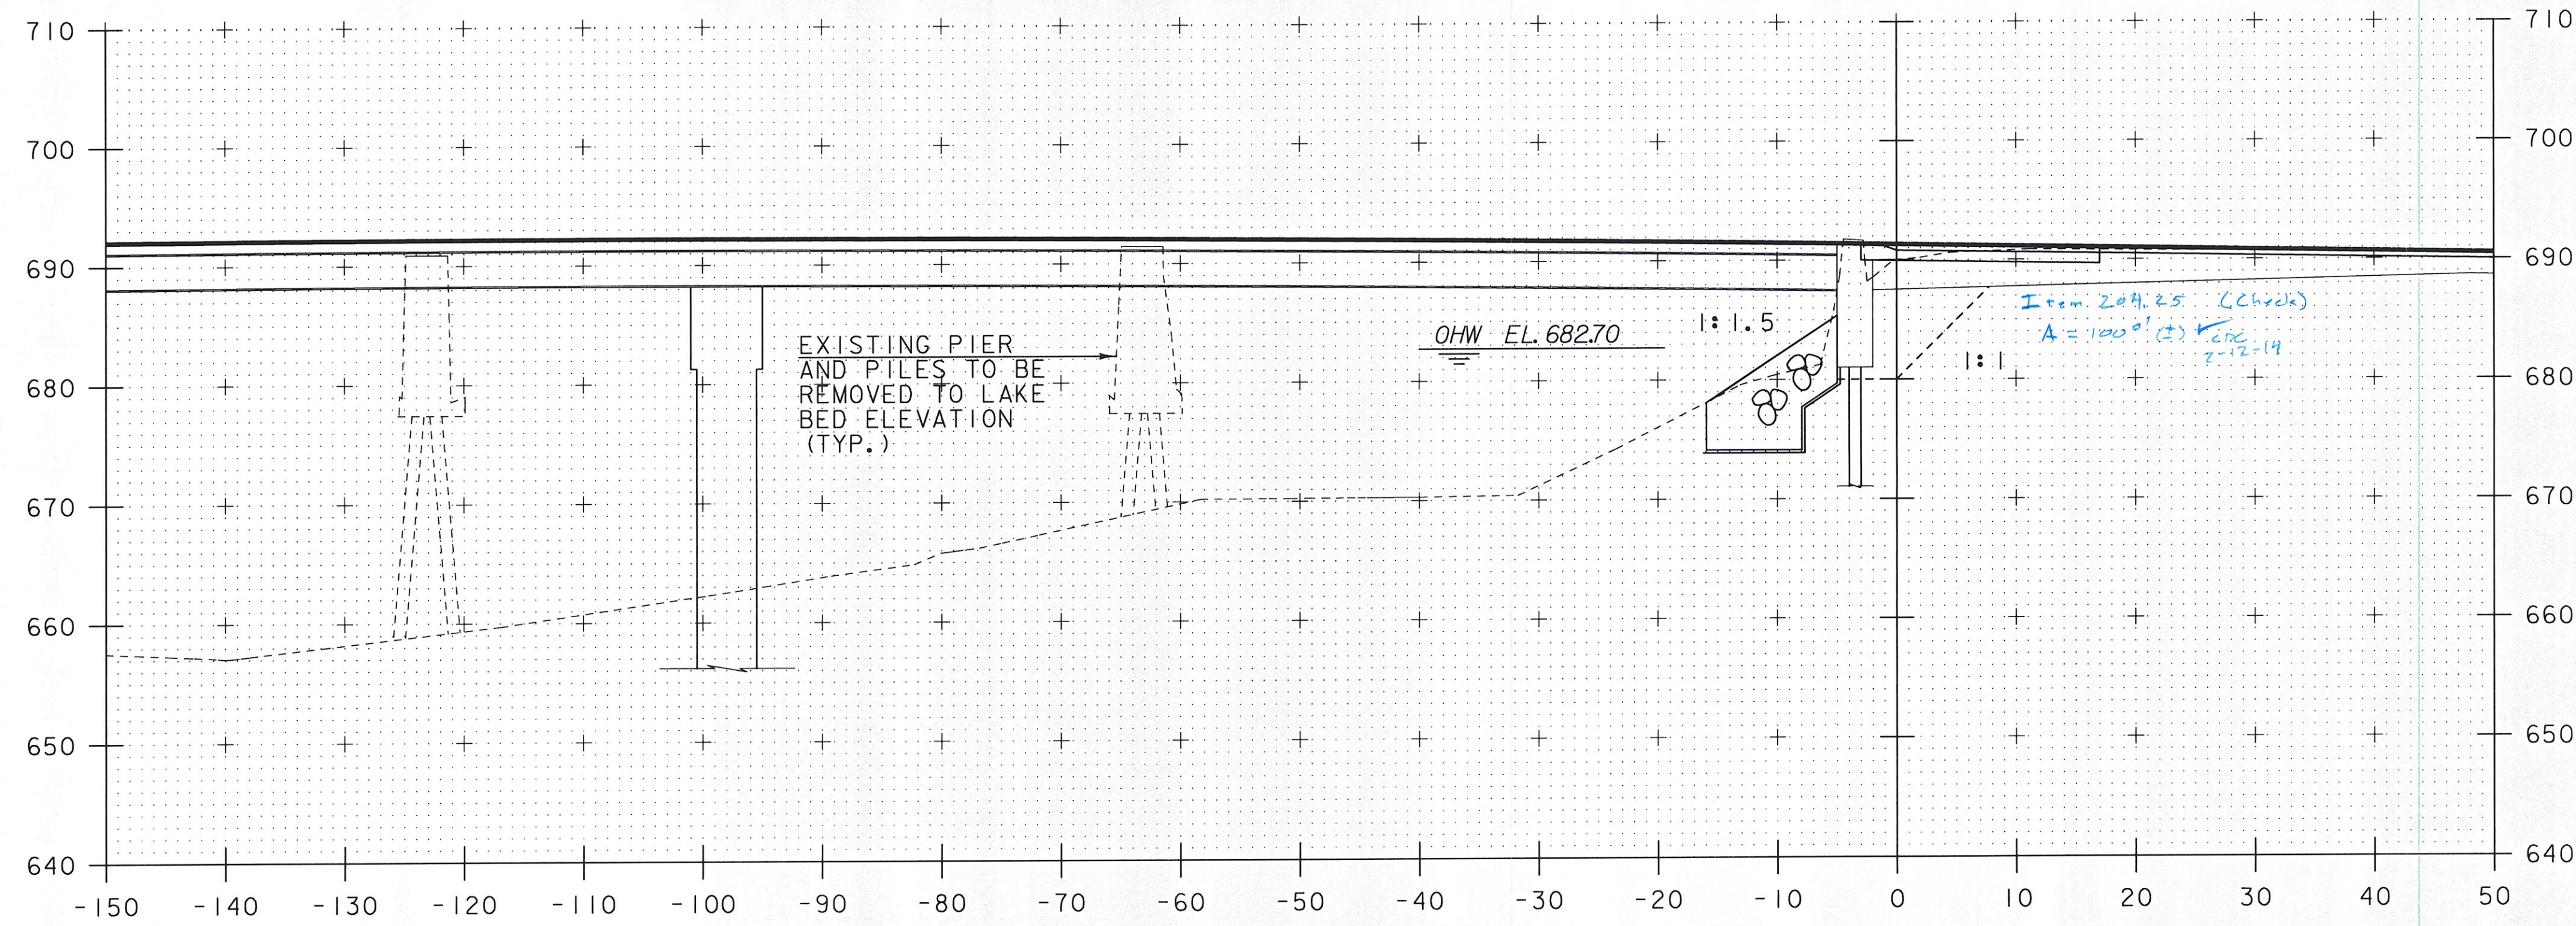

50+90

STA. 50+86 RT  
 END STRUCTURE EXCAVATION  
 STA. 50+91 RT  
 BEGIN GRUBBING MATERIAL

CHANNEL RT. STA. 50+90 TO STA. 51+00

PROJECT NAME: NEWPORT CITY	PLOT DATE: 22-NOV-2011
PROJECT NUMBER: BRO 1449(25)	DRAWN BY: C. MOONEY
FILE NAME: 96J314/STR/96J314xsl.dgn	CHECKED BY: C. CARLSON
PROJECT LEADER: C. CARLSON	SHEET 65 OF 75
DESIGNED BY: D. PETERSON	
ABUTMENT 2 CHANNEL SECTION 5	