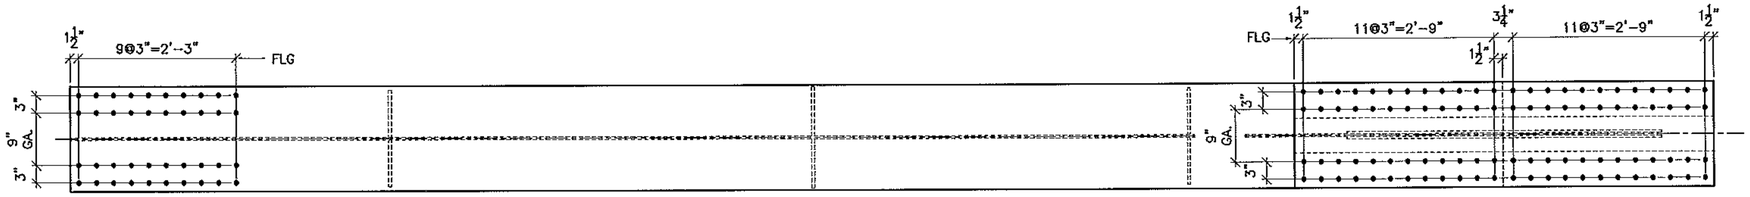

TOP VIEW (BOTTOM VIEW SIM.)

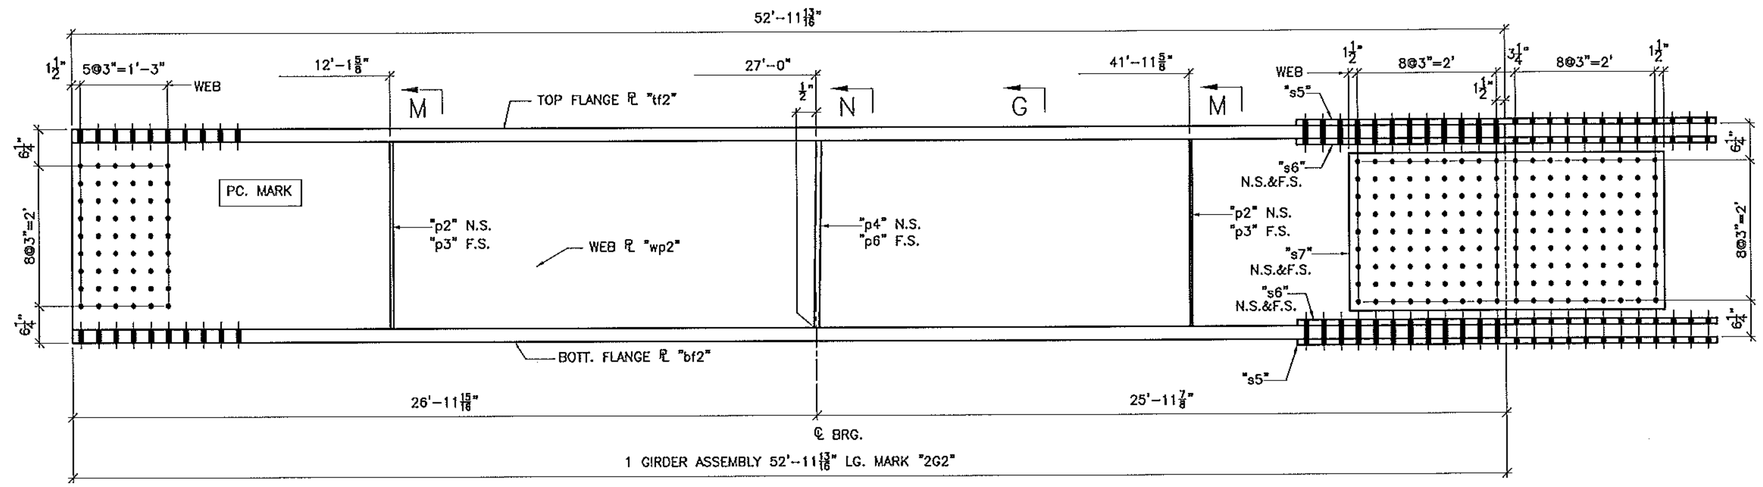

BILL OF MATERIAL

SHIP	SHIP MARK	NO. PCS.	PIECE MARK	DESCRIPTION	LENGTH	REMARKS	WT.
1	2G2			BRIDGE GIRDER			
		1	wp2	℄ ½X32	52'-11 13/16"		2886
		1	tf2	℄ 2½X18	52'-11 13/16"		7305
		1	bf2	℄ 2½X18	52'-11 13/16"		7305
		1	p8	SEE SHT. 26			
		2	p2	SEE SHT. 26			
		1	p4	SEE SHT. 26			
		2	p3	SEE SHT. 26			
		2	S5	SEE SHT. 26			
		4	S6	SEE SHT. 26			
		2	S7	SEE SHT. 26			

GIRDER WT: 19,314

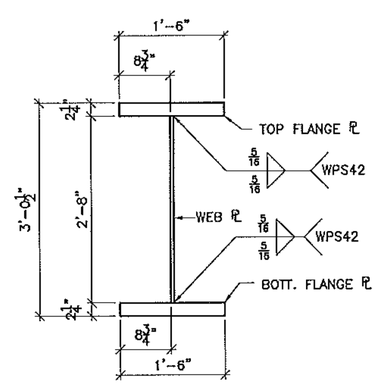

SECTION G
(GIRDER ASS'Y)

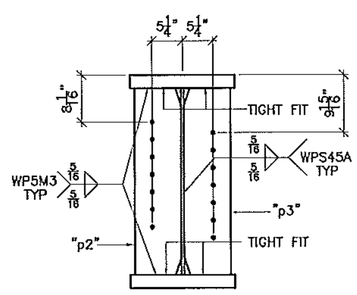

SECTION M

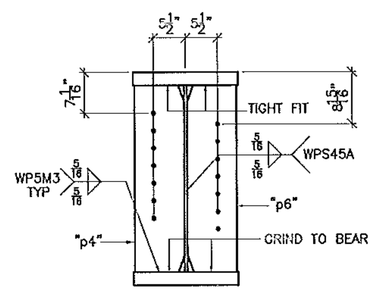

SECTION N

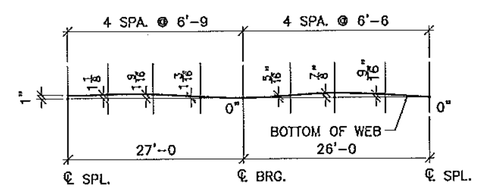

CAMBER DIAGRAM

Vermont Agency of Transportation
RECEIVED
CK'D BY GFR OK'D BY
05/15/2012
RESUBMIT APPROVED X
BY C. CARLSON DATE 05/16/2012

SEE .dxf FILES FOR WEB ℄ CUTTING

SEE SHEET 26 FOR PIECE DETAILS

SEE SHEET B1 FOR NOTES

FINISH				
MATERIAL AASHTO M270 (ASTM A709) GRADE 50				
HOLES 15/16"ø U.O.N.				
ELECTRODES				
WELDS PER WPS				
SURFACE PREP	1	5/15/12	PER APPROVAL	JAC
	NO	DATE	DESCRIPTION	BY
	REVISIONS			

ARC ENTERPRISES, INC.
ADVANCED RESOURCES & CONST. ENTERPRISES, INCORPORATED
P.O. BOX 120 KINGFIELD, ME. 04947
PHONE: (207) 265-2648 – FAX: (207) 265-4054

DRAFTER JAC	STRINGER DETAILS		CONTRACT NO. BRO 1449 (25)
DATE 4/11/12	VERMONT AGENCY OF TRANSPORATION, NEWPORT CITY, CO. OF ORLEANS RAILROAD SQUARE, TH11 (CLASS 2) MAJOR COLLECTOR, BRIDGE NO. 9		
CHECKED JS	O.C.		DWG. NO.
JOB # 12-100	REED & REED		7

J.A.C. DRAFTING/515/12/07

PDF created with FinePrint pdfFactory trial version http://www.pdffactory.com