BILL OF MATERIAL

SHIP	SHIP MARK	NO. PCS.	PIECE MARK	DESCRIPTION	LENGTH	REMARKS	WT.
1	5G4			BRIDGE GIRDER			
		1	wp5	PL ½X32	62'-5⅞		3403
		1	tf5	PL 1½X18	62'-5⅞		4788
		1	bf5	PL 1½X18	62'-5⅞		4788
		2	p1	SEE SHT. 26			
		4	p2	SEE SHT. 26			
		4	p3	SEE SHT. 26			

GIRDER WT: 13,397

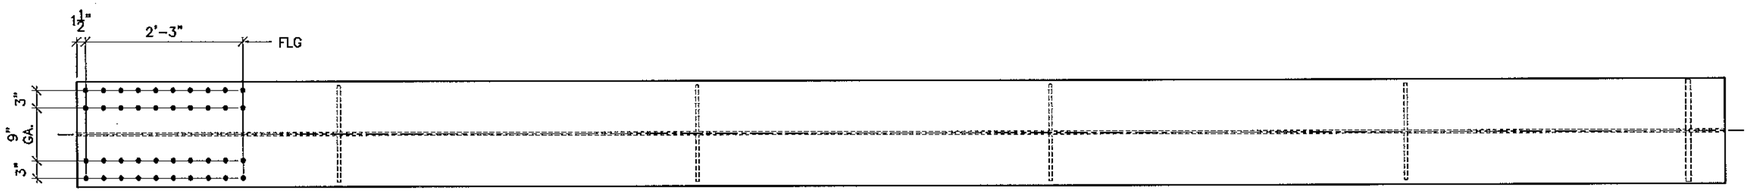

TOP VIEW (BOTTOM VIEW SIM.)

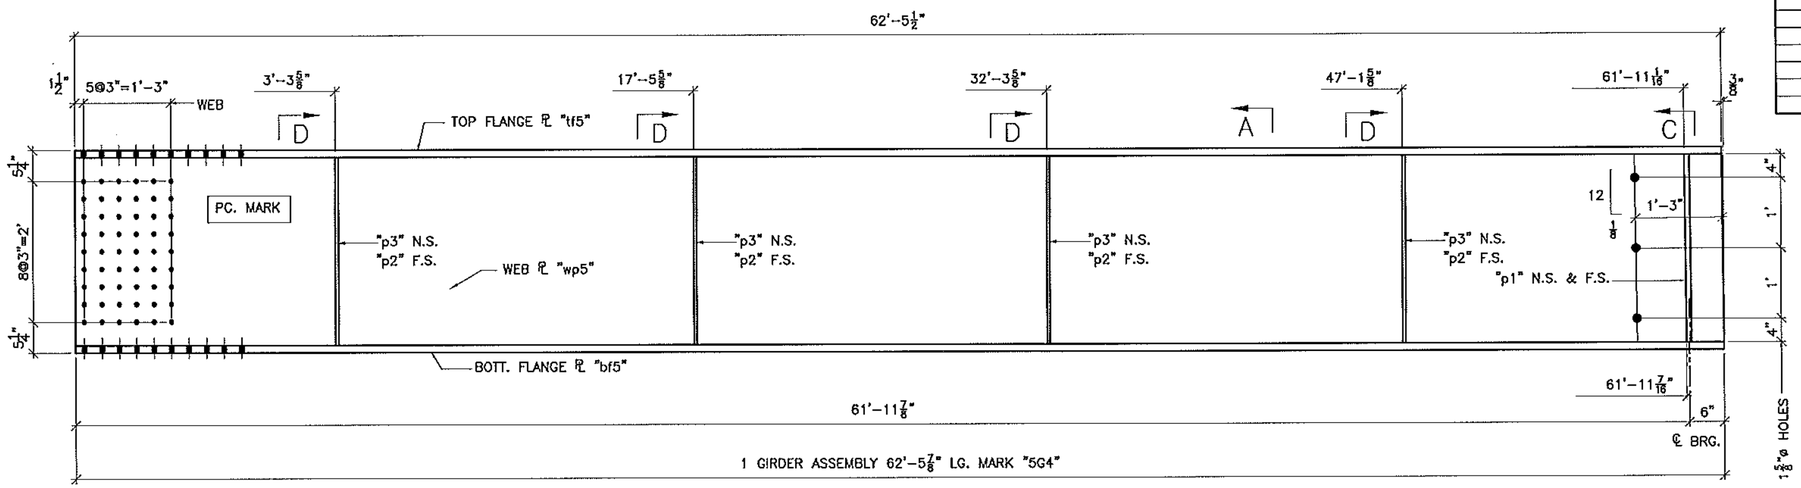

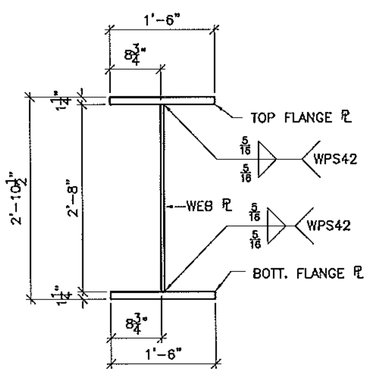

SECTION A
(GIRDER ASS'Y)

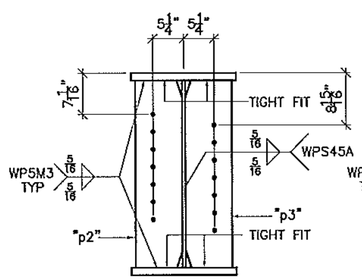

SECTION D

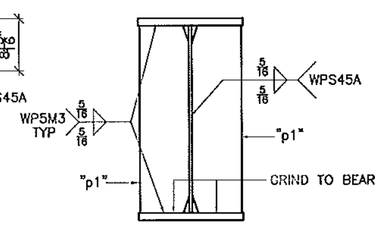

SECTION C

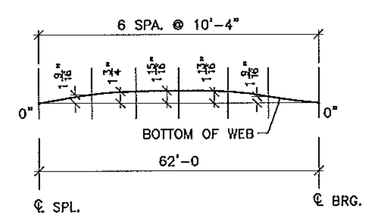

CAMBER DIAGRAM

Vermont Agency of Transportation
RECEIVED
CK'D BY GFR OK'D BY
05/15/2012
RESUBMIT APPROVED X
BY C. CARLSON DATE 05/16/2012

SEE .dxf FILES FOR WEB PL CUTTING

SEE SHEET 26 FOR PIECE DETAILS

SEE SHEET B1 FOR NOTES

FINISH				
MATERIAL AASHTO M270 (ASTM A709) GRADE 50				
HOLES 15/16"ø U.O.N.				
ELECTRODES				
WELDS PER WPS				
SURFACE PREP	1	5/15/12	PER APPROVAL	JAC
	NO	DATE	DESCRIPTION	BY

REVISIONS

ARC ENTERPRISES, INC.

ADVANCED RESOURCES & CONST. ENTERPRISES, INCORPORATED
P.O. BOX 120 KINGFIELD, ME. 04947
PHONE: (207) 265-2646 – FAX: (207) 265-4054

DRAFTER JAC	STRINGER DETAILS	CONTRACT NO. BRO 1449 (25)	
DATE 4/11/12	VERMONT AGENCY OF TRANSPORTATION, NEWPORT CITY, CO. OF ORLEANS RAILROAD SQUARE, BH11 (CLASS 2) MAJOR COLLECTOR, BRIDGE NO. 9		
CHECKED JS	G.C. REED & REED	DWG. NO. 24	
JOB # 12-100			

J.A.C. DRAWING/S15B12/024

PDF created with FinePrint pdfFactory trial version http://www.pdffactory.com