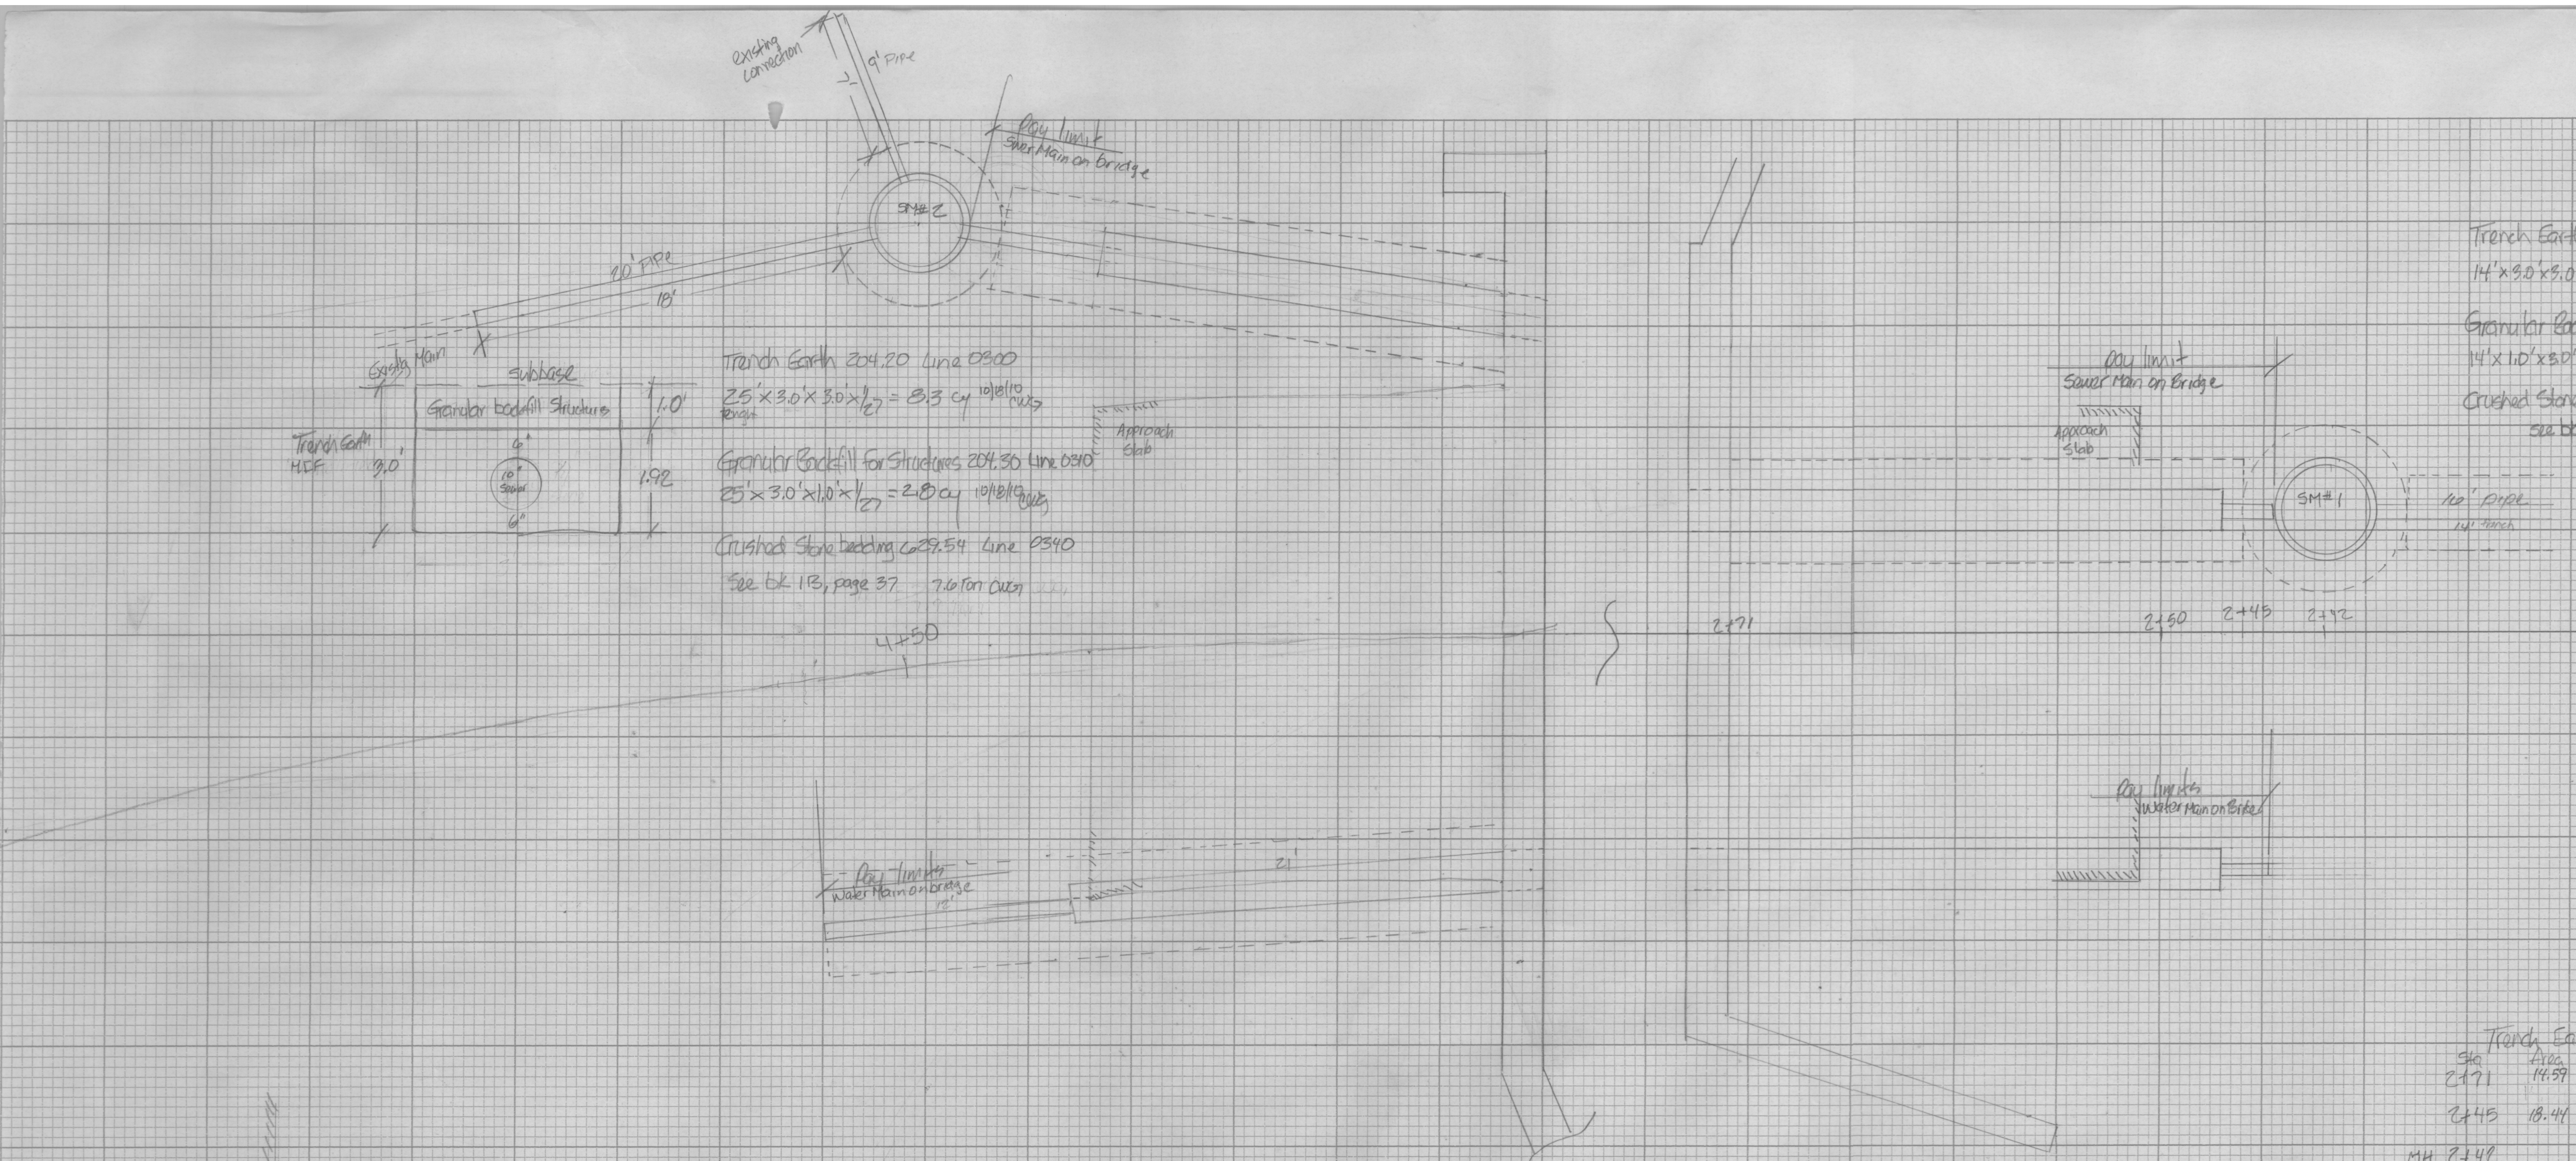

Trench Earth 204.20 Line 0300
25'×3.0'×3.0'×1/27 = 8.3 cy 10/18/10 cwg
length

Granular Backfill for Structures 204.30 Line 0310
25'×3.0'×1.0'×1/27 = 2.8 cy 10/18/10 cwg

Crushed Stone bedding 629.54 Line 0340
See bk 1B, page 37 7.6 Ton cwg

Trench Earth 204.20 Line#0300
14'×3.0'×3.0'×1/27 = 4.7 cy 10/19/10 cwg

Granular Backfill for Structures 204.3 Line#03
14'×1.0'×3.0'×1/27 = 1.6 cy 10/19/10 cwg

Crushed Stone bedding 629.54 Line#0340
see bk 1B pg 37 4.2 Ton

Trench Earth-(Sewer)

Sta	Area	Dist	Vol
2+71	14.59	26'	15.90 cy
2+45	18.44		
MH 2+42			8.99 cy

24.89 11/10/09

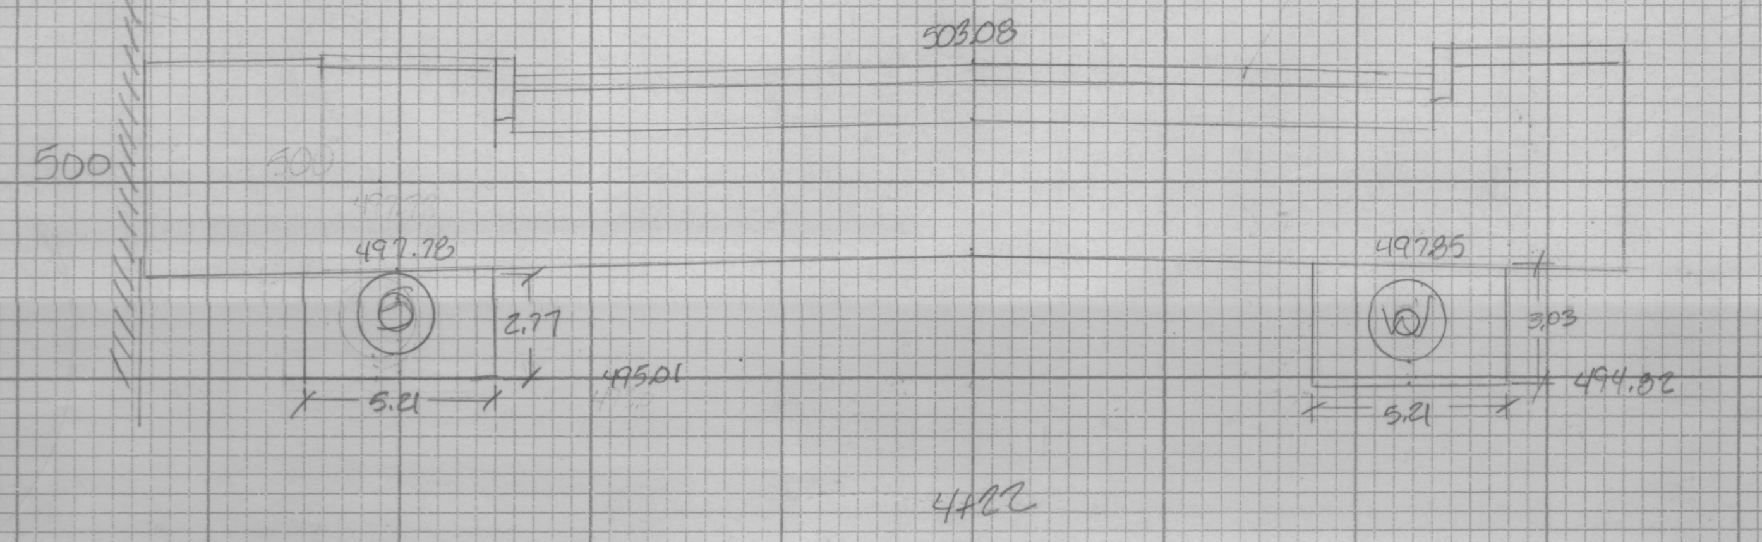

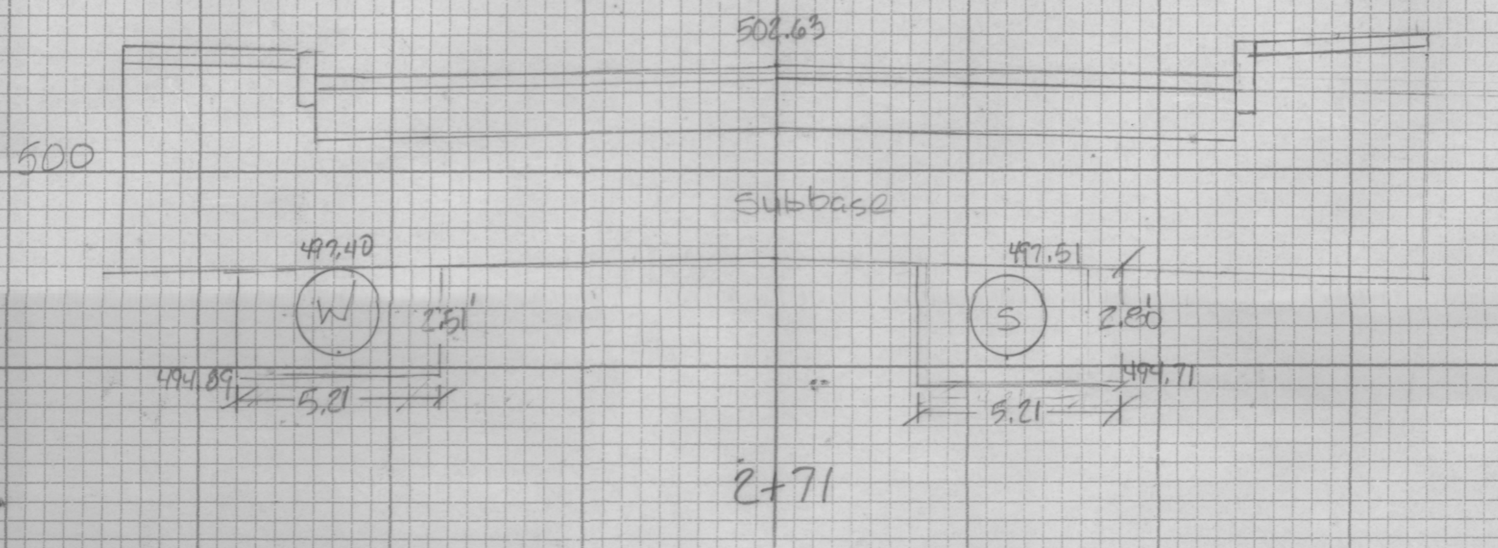

Trench Earth-(Water)

Sta	Area	Dist	Vol
2+71	13.08	24'	18.04 cy
2+45	27.51		

11/3/09 cwg

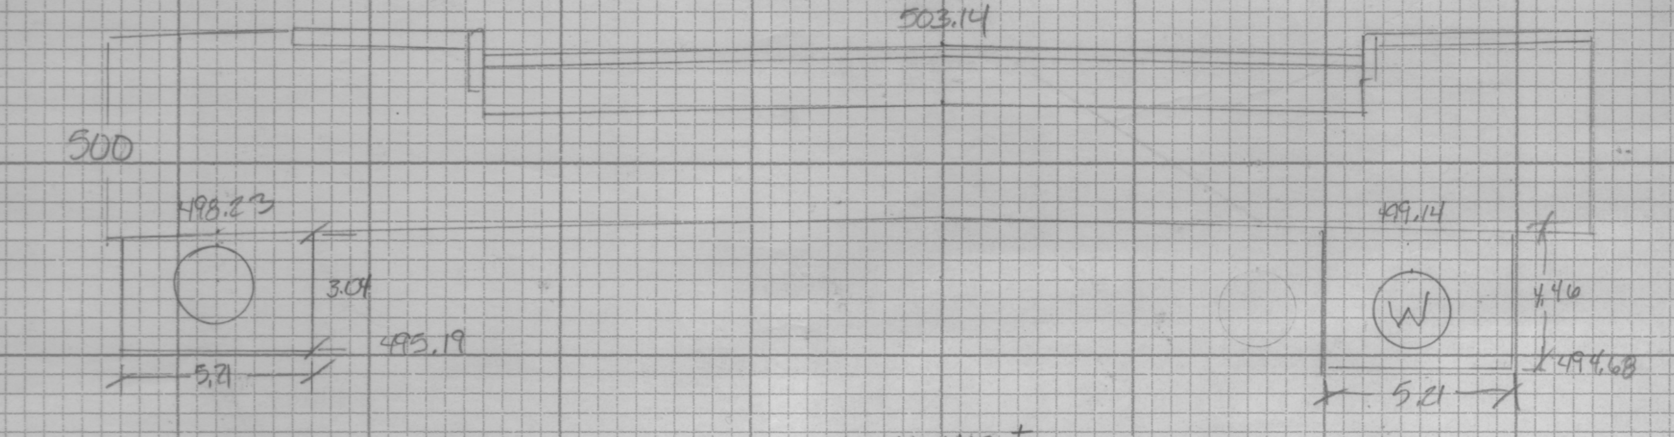

4+47±

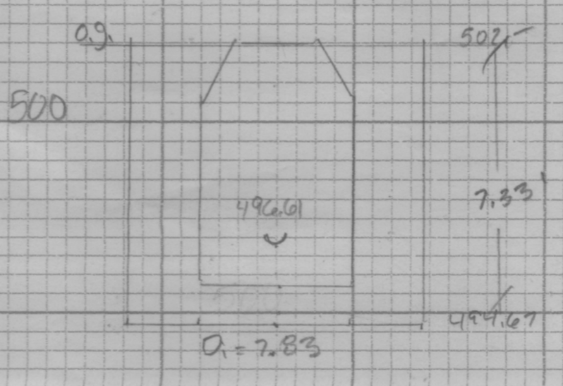

Trench Earth Sewer

Sta	Area	Dist	Vol
4+22	14.43	25'	14.00 cy
4+47	15.83		
MH	$\frac{\pi 7.83^2}{4} \times 7.33 = 13.07$ cy		

27.07 11/8/09 cwg

Trench Earth water

Sta	Area	Dist	Vol
4+22±	16.0	33'	23.83 cy
4+55±	23.0		

11/09/09 cwg

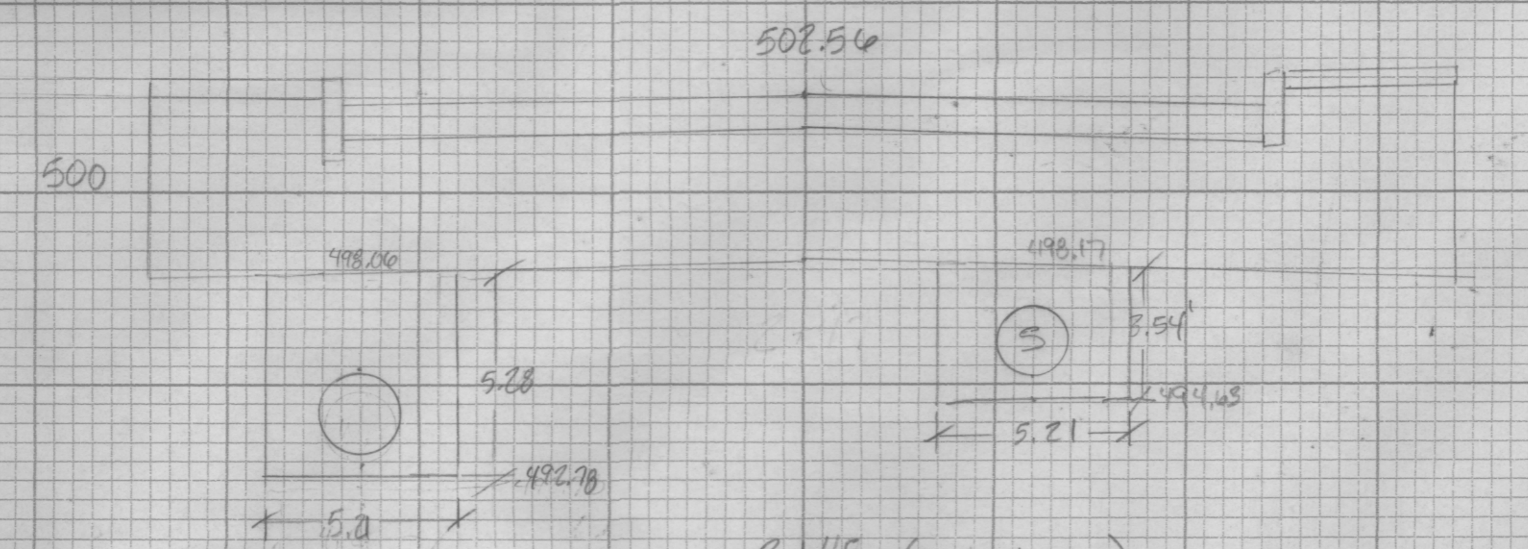

2+45 (end sleeves)

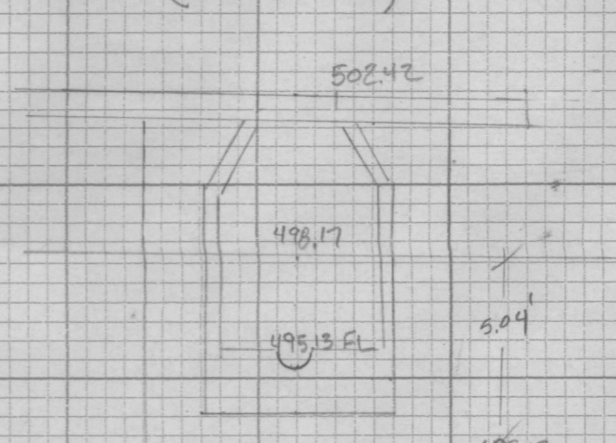

CHARLES BRUNING COMPANY
CROSS SECTION 10 x 10
PRINTED IN U.S.A.