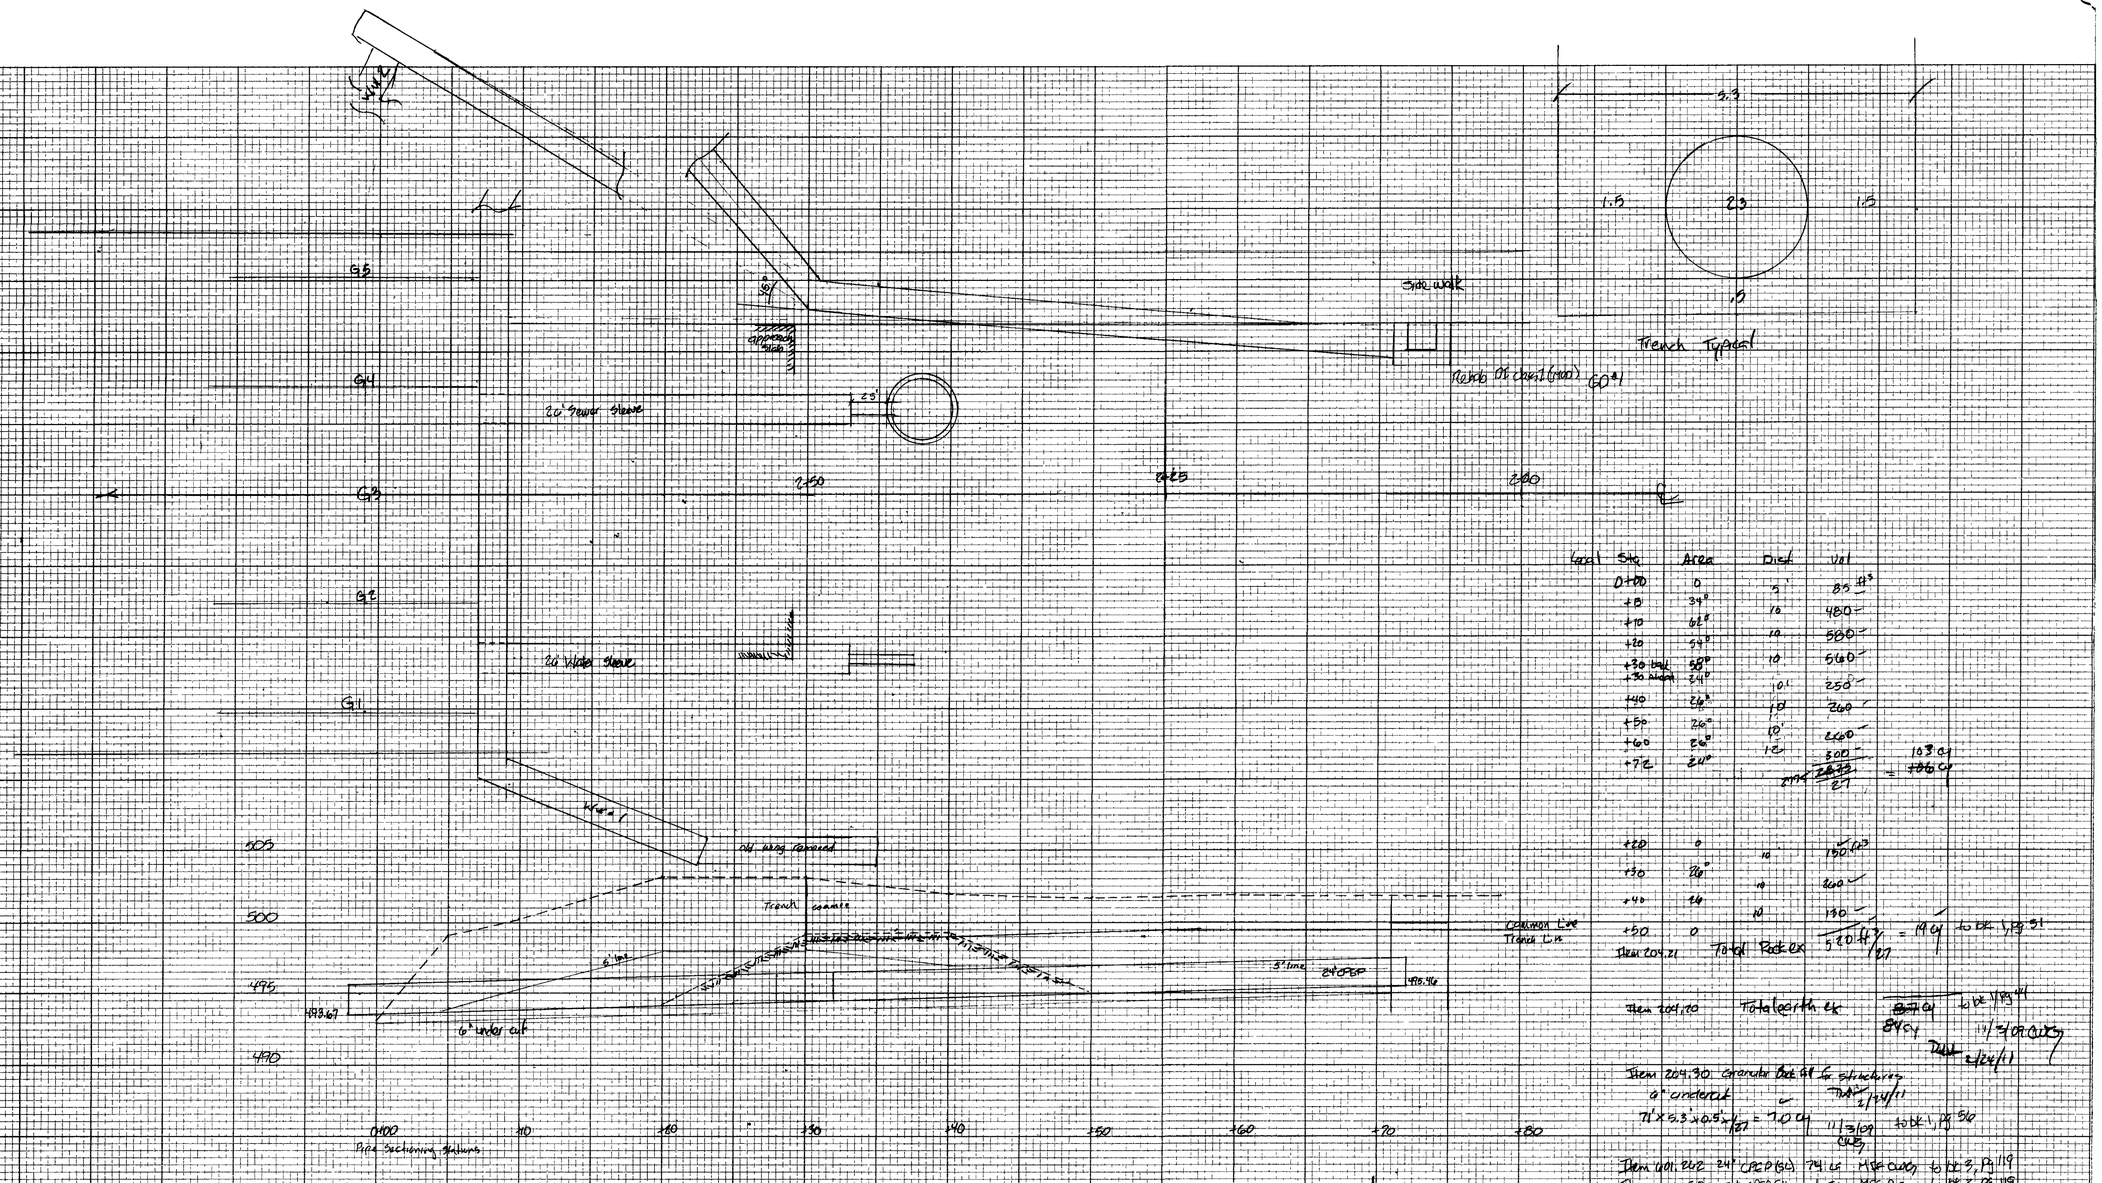

Loc	Sta	Area	Dist	Vol
	0+00	0	5'	85 ft³
	+5	34°	10	480
	+10	68°	10	500
	+20	54°	10	560
	+30 bwl	50°	10	560
	+30 ahead	24°	10'	250
	+40	26°	10	260
	+50	26°	10'	260
	+60	26°	10	260
	+70	24°	10	300
			2.94	2673 / 27 = 103 cy ~~106 cy~~

	+20	0	10	150 cy
	+30	26°	10	260
	+40	26	10	260
	+50	0	10	130
Item 204.21		Total Rock ex		520 cy / 27 = 19 cy to bk 1, pg 51

Item 204.20 Total earth ex ~~84 cy~~ 84 cy to bk 1, pg 44 11/3/09 CWB

Item 204.30 Granular bed of structures
6" underout
71' x 5.3' x 0.5' x 1/27 = 7.0 cy 11/3/09 CWB to bk 1, pg 56

Item 601.242 24" CPEP (SL) 74 LF MSC CWB to bk 3, Pg 119
Item 601.58a 24" CPEP Elbow 1 EA MSC CWB to bk 3, Pg 119

New Drainage 24" CPEP

Project sheet 6/6

CHARLES BRUNING COMPANY
CROSS SECTION 10 x 10
PRINTED IN U.S.A.

CHARLES BRUNING COMPANY
CROSS SECTION 10 x 10
PRINTED IN U.S.A.