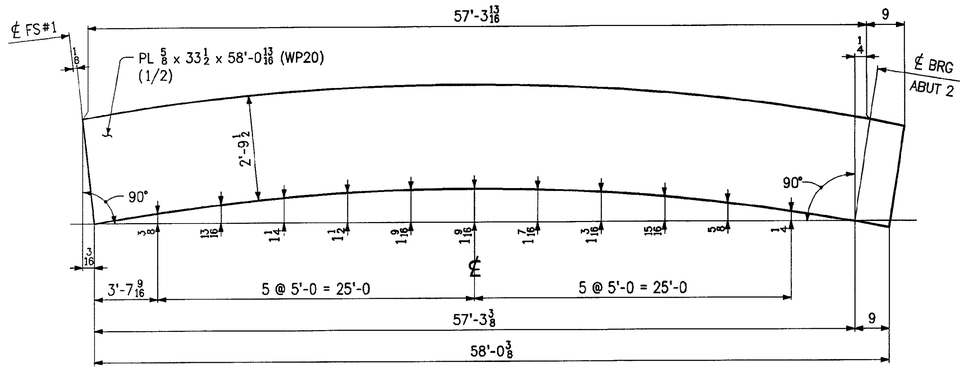

WEB CUTTING DIAGRAM FOR 20G4B

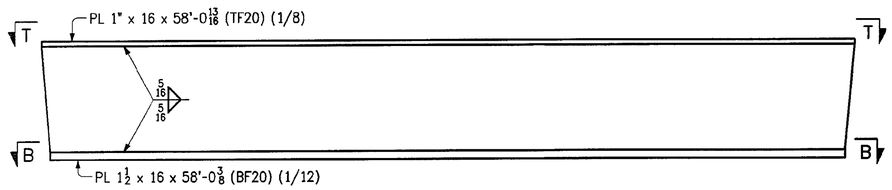

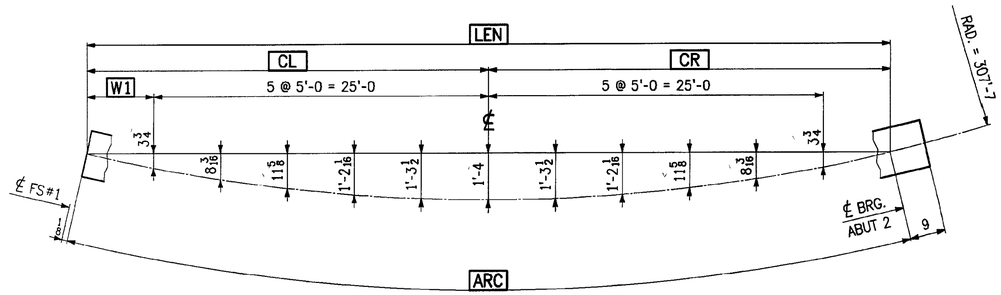

LOCATION	ARC	LEN	CL	CR	W1
VIEW T-T	57'-3 13/16	57'-2 13/16	28'-7 3/8	28'-7 7/16	3'-7 3/8
SECT. B-B	57'-3 3/8	57'-2 3/8	28'-7 3/16	28'-7 3/16	3'-7 3/16

NOTES:

1. FOR GENERAL NOTES, SEE DWG. GN1
2. ALL MATERIAL SHALL BE M270-50W (CVN).

Accepted ✓
Accepted as Noted
Accepted Noted Resubmit
Rejected, Revise Resubmit
Rejected - Unacceptable

Checking is only for conformance with the design concept of the Project and compliance with the information given in the Contract Documents. The Engineer assumes no liability for errors or omissions that may be contained herein. The Contractor, by approving and submitting these documents, verifies their accuracy as stipulated on the Contractor's Shop Drawing Stamp

DATE 7/7/09 DuBOIS AND KING By [illegible]

RECEIVED
CK'D BY JEL CK'D BY KMH
JUN 18 29
APPROVED ✓
BY KMH DATE 7/13/09

REVISIONS			PRINT RECORD		
NO	DATE	DESCRIPTION	DATE	QTY	ISSUED
			6-15	E	APPR.

MEGQUIER & JONES INC.

STRUCTURAL STEEL SINCE 1895
1156 BROADWAY
SOUTH PORTLAND, MAINE 04106

PAINT	HOLES U N	WELD U N	Q C REVIEW
PROJECT: TH NO.1 OVER THE GIHON RIVER PROJECT NO. BHO 1448 (29) BRIDGE NO. 5 TOWN OF JOHNSON, VERMONT			DATE 6-4-09 DRAWN BY RLK 5-27-09
DESCRIPTION. CAMBER DIAGRAMS			CHK'D BY GDC
ARCH N/A	ENGR VERMONT AGENCY OF TRANSPORTATION		JOB NO J-81
CUSTOMER S.D. IRELAND CONCRETE CONSTRUCTION CORP.			SHT NO 9

998-4 WC998J

Sheet 9 Plotted 06/17/2009 @ 10:20 (KCAT CS)